


Section 34 Township 12 Range 16 WWell No. # 4 Froelich "A"Company Kewanee Oil

NORTH

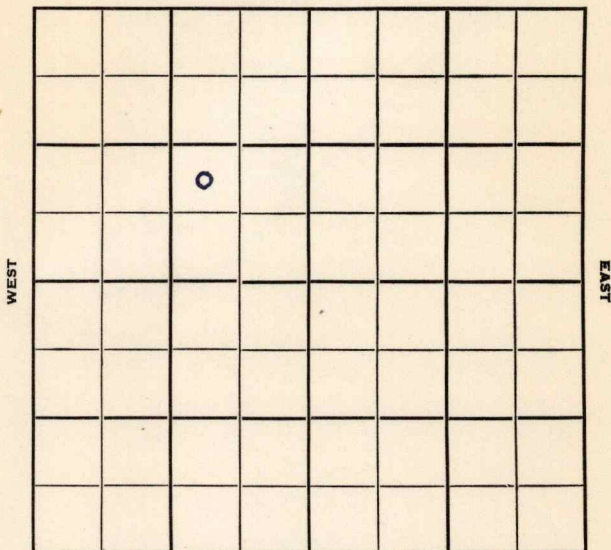

SOUTH

Ellis KANSAS

Sec. 34 Twp. 12 R. 16 W ✓

Well No. # 4 Froelich "A" Farm

Kewanee Oil Company

Lohman & Johnson Contractor

Emmerman Pool


Ft. from N. Line

990 Ft. from S. Line

990 Ft. from E. Line

Ft. from W. Line

NW SE NW

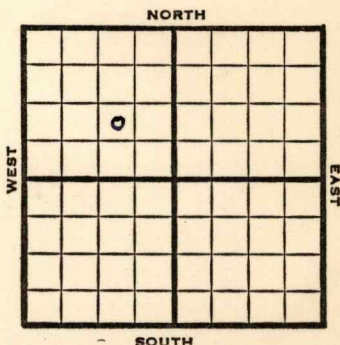

1951

Elev. 2054'

REPORT

2/28

Spud 2-22-51
10-3/4" @ 240'
Drilg. 1800'

Anhy 1200-35

4/25

Spud 2-22-51
Oil well TD 3534'
10-3/4" @ 240' Anh6 1200-35'
Heeb 3218' Dodge 3240', Lans 3270'
Arb. 3523-30'
5" @ 3523' S/10 BO 12 hr.
S/5 BO next 12 hr. DD 3534'
Comp. 29 BOPD

COMPLETED

County Ellis State Kansas
 Sec. 34 (Blk.) 12 (Sur.) 16W Map No.
 Operator Kewanee Oil
 Well No. 4 Farm Froelich "A"
 Elev. _____ Location NW SE NW



990 Ft. From S Line NW
990 Ft. From E Line Quarter

1st. Report FEB 28 1951

Completion _____

Remarks _____

Lohman & Johnson - Contr

Spudding Date 2-22-51

Drlg. Data

Emmerman Peel

10 3/4" @ 240 Anhy 1200-35 drlg. 1800

J. E. TYRA

County	Ellis	State	Kansas
Sec.	34 (Blk. Twp.)	12 (Sur. Rge.)	16W Map No.
Operator	Kewanee Oil		
Well No.	4	Farm	Froelich "A"
Elev.	2054	Location	NW SE NW
		990 Ft. From S Line NW	
		990 Ft. From E Line Quarter	
		1st. Report	
		Completion APR 25 1951	
		Remarks Emmerman Pool	
		Lohman & Johnson - Contr.	
		Spudding Date 2-22-51	

Drlg. Data Oil well TD 3534
 10 3/4" @ 240 Anhy 1200-35 Heeb. 3218
 Dodge 3240 Lans. 3270 Arb. 3523-30
 5" @ 3523 S/ 10 bo 12 hr. S/ 5 bo next
 12 hr. DD 3534 Comp. 29 bopd

J. E. TYRA