

KANSAS

Form 51-5M-7-40-Palace


Barton

Section 10 Township 17 Range 11-W

Well No. 7 Kraft

Company Carter & Phillips

NORTH Kraft Pool

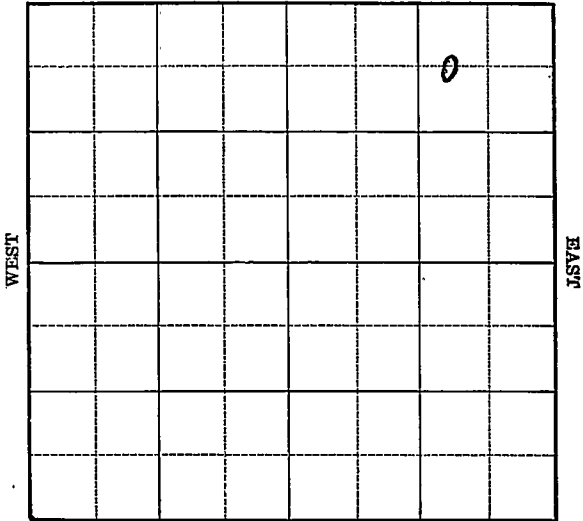

SOUTH

Sec. 10 Twp. 17 R. 11-W

Well No. #7 Kraft Farm

Carter & Phillips Company

(Kraft)


660 Ft. from N. Line

_____ Ft. from S. Line

990 Ft. from E. Line

_____ Ft. from W. Line

Elev. 1865

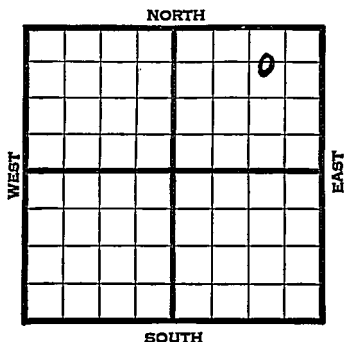

1941	REPORT
2/26	Location
3/6	Rotary.
3/13	8" - 236' Drlg. 2065'
3/20	Topeka 2630' Douglas 2930' Lans. 3005' Drlg. 3165'
3/27	Arb. 3273' 5" - 3273' T.D. 3276' 3050' oil.
4/2	Arb. 3273'
	5" - 3273'
	T.D. 3276'
	Echometer potential 5227 bbls.
	Maximum 3000 bbls.
	43.6 Gravity
	COMPLETED

Map No. 53 Sec. 10 Twp. 17 R. 11WWell No. 7 KraftCarter & Phillips

Company

~~FIRST REPORT~~

Contractor

C W L NE NE

660 Ft. from N. Line Ft. from S. Line990 Ft. from E. Line Ft. from W. Line

KRAFT POOL

SECTION PLAT

			o

Location XRig up

Drilling and Remarks:

RECORD

Cased in., ft.Sand Gas Oil Total Depth

PRODUCTION

1st 24 hrs. Nat. 1st 24 hrs. after shot Gas Cu. Ft.Dry Hole Abandoned

Date

FEB 26 1941 19S. J. LEWIS

Scout

Map No. 53 Sec. 10 Twp. 17 R. 11W

Well No. 7 Kraft

Garter & Phillips Company

COMPLETED Contractor

SECTION PLAT

C W L N E N E
660 Ft. from N. Line
_____ Ft. from S. Line
990 Ft. from E. Line
_____ Ft. from W. Line

			0

KRAFT POOL

Location _____

Rig up _____

Drilling and Remarks:

See 83273
5" @ 3278
Echd Pa 85227
May 3000
43 6 Gr.

RECORD

Cased _____ in., _____ ft.
Sand _____
Gas _____
Oil _____
Total Depth 3276

PRODUCTION

1st 24 hrs. Nat. _____
1st 24 hrs. after shot _____
Gas _____ Cu. Ft.
Dry Hole _____
Abandoned _____

Date

APR 2 1941 19

S. J. LEWIS Scout