

KANSAS

Barton

Form 51-5M-7-40-Palace


Section 10 Township 17 Range 11-W

Well No. #8 Kraft

Company Carter & Phillips

Kraft Pool

NORTH

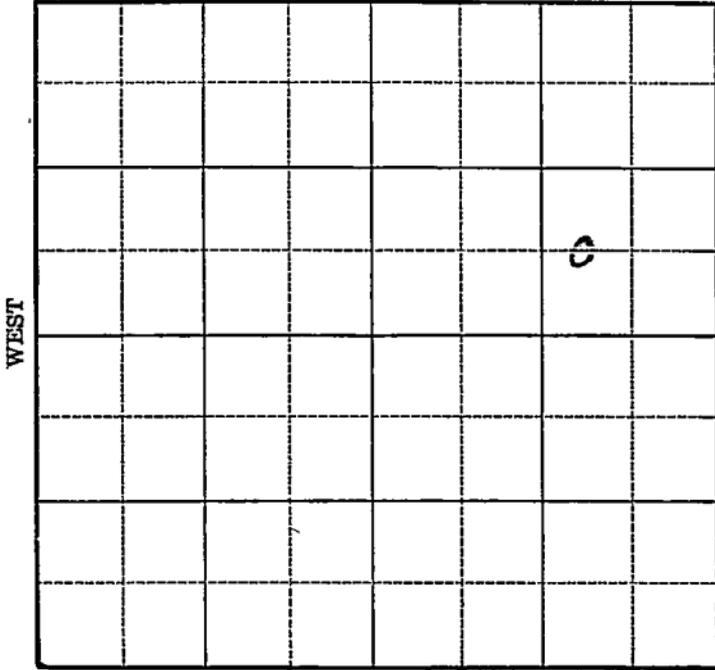

SOUTH

Sec. 10 Twp. 17 R. 11-W

Well No. #8 Kraft Farm

Carter & Phillips Company

(Kraft)


_____ Ft. from N. Line

660 Ft. from S. Line

990 Ft. from E. Line

_____ Ft. from W. Line

Elev. 1867

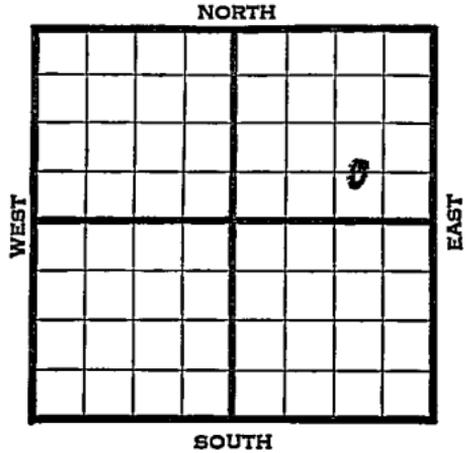

1941	REPORT
4/2	Rotary.
4/10	8" - 240' Drlg. 2369'
4/18	Top. 2640' Lansing 3027'
	S.O. 3059 -64' Arb. 3285 ³²⁸⁵ -92' TD
	S.O. 5" - 3285 RUST.
4/24	Arb. 3285' (Corrected)
	5" - 3285' T.D. 3295'
	2000 acid.
5/1	T.D. 3301' 3000 acid.
	Pump 184 oil 10 hours.
5/8	Pump 416 oil 10 hours.
5/14	Arb. 3285'
	5" - 3285'
	T.D. 3301'
	5000 acid.
	Potential 550 bbls., pump.
	43.6 Gravity
	COMPLETED

Map No. 55 Sec. 10 Twp. 17 R. 11W

Well No. 8 Kraft

Carter & Phillips Company

~~FIRST REPORT~~ Contractor

C W L S E N E

 Ft. from N. Line

660 Ft. from S. Line

990 Ft. from E. Line

 Ft. from W. Line

SECTION PLAT

			o

KRAFT POOL

Location

Rig up

Drilling and Remarks:

Rot ary

RECORD

Cased in., ft.

Sand

Gas

Oil

Total Depth

PRODUCTION

1st 24 hrs: Nat.

1st 24 hrs. after shot

Gas Cu. Ft.

Dry Hole

Abandoned

Date

APR 2 1941₁₉

S. J. LEWIS Scout

Map No. 55 Sec. 10 Twp. 17 R. 11WWell No. 8 KraftCarter Oil

Company

Contractor

COMPLETE**SECTION PLAT****C W L SE NE**

_____ Ft. from N. Line

660 Ft. from S. Line990 Ft. from E. Line

_____ Ft. from W. Line

			o

KRAFT POOL

Location _____

Rig up _____

Drilling and Remarks:

*Cu 73285.**5" @ 3285.**5000 aciol**Pump 550 P & X**436 3E***RECORD**

Cased _____ in., _____ ft.

Sand _____

Gas _____

Oil _____

Total Depth 3301**PRODUCTION**

1st 24 hrs. Nat. _____

1st 24 hrs. after shot _____

Gas _____ Cu. Ft.

Dry Hole _____

Abandoned _____

Date

MAY 14 1941 19S. J. LEWIS

Scout