

Barton


KANSAS

Form 51-5M 5-37 Petrol

Section 11 Township 17 Range 11-W

Well No. #1 Dennis Hogan

Company Carter Oil

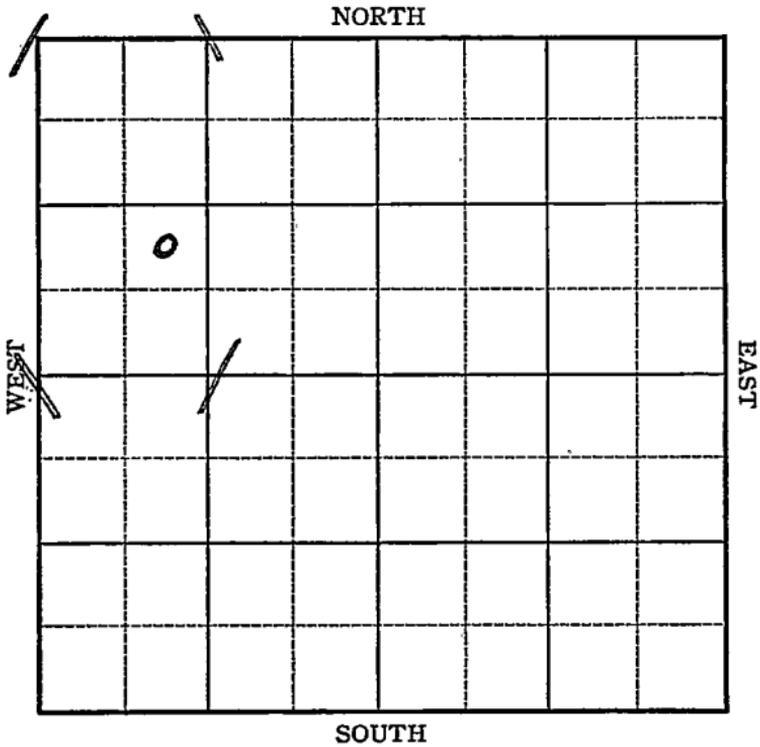

Sec. 11 Twp. 17 R. 11-WWell No. #1 Dennis Hogan FarmCarter Oil Company


\_\_\_\_\_ Ft. from N. Line

990 Ft. from S. Line

\_\_\_\_\_ Ft. from E. Line

990 Ft. from W. Line

Elev. 1900

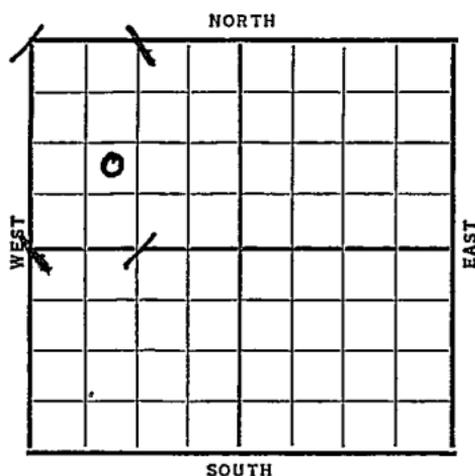

Date	REPORT
1937	
9/22	B. R. R.
10/2	10" @ 209'. Drlg. 455'.
10/8	Drlg. 2800'.
10/15	K.C. 3083'. Sil. 3326'.
	S.O. 3326-31'. T.D. 3336'.
	Rng. 7".
10/22	7" @ 3325'. T.D. 3336'.
	2400' oil 1 hrs.
10/27	7" @ 3325'.
	Sil. 3326'.
	T.D. 3336'.
	Pump 323.85 bbls. 4 hrs &
	315 bbls. 4 hrs.
	Potential 1890 bbls.
	Gravity 44.8
	COMPLETED

*Barton* KANSAS

Map No. \_\_\_\_\_ Sec. 11 Twp. 17 R. 11W

Well No. 1 - Dennis Hagan

Carter Oil Company

Contractor

**FIRST REPORT**

**SECTION PLAT**

\_\_\_\_\_ Ft. from N. Line

990 Ft. from S. Line

\_\_\_\_\_ Ft. from E. Line

990 Ft. from W. Line

o			

Location \_\_\_\_\_

Rig up \_\_\_\_\_

Drilling and Remarks:

*BRR.*

**RECORD**

Cased \_\_\_\_\_ in., \_\_\_\_\_ ft.

Sand \_\_\_\_\_

Gas \_\_\_\_\_

Oil \_\_\_\_\_

Total Depth \_\_\_\_\_

**PRODUCTION**

1st 24 hrs. Nat. \_\_\_\_\_

1st 24 hrs. after shot \_\_\_\_\_

Gas \_\_\_\_\_ Cu. Ft.

Dry Hole \_\_\_\_\_

Abandoned \_\_\_\_\_

Date

SEP 22 1937

19

H. D. Hatfield

Scout

Barton KANSAS

Map No. \_\_\_\_\_ Sec. 11 Twp. 17 R. 11WWell No. 1 Dennis HoganCarter Oil Company

Contractor \_\_\_\_\_

**COMPLETED**

NE SW NW

\_\_\_\_\_ Ft. from N. Line

990 Ft. from S. Line

\_\_\_\_\_ Ft. from E. Line

990 Ft. from W. Line**SECTION PLAT**

0			

Location \_\_\_\_\_

Rig up \_\_\_\_\_

Drilling and Remarks:

P-323.85/4 + 315/4

Pot-1890

grav-44.8

**RECORD**Cased 7 in., 3325 ft.Sand 511 3326

Gas \_\_\_\_\_

Oil \_\_\_\_\_

Total Depth 3336**PRODUCTION**

1st 24 hrs. Nat. \_\_\_\_\_

1st 24 hrs. after shot \_\_\_\_\_

Gas \_\_\_\_\_ Cu. Ft.

Dry Hole \_\_\_\_\_

Abandoned \_\_\_\_\_

Date

OCT 27 1937 19H. D. Hatfield Scout