


Section 34 Township 12 Range 16W

Well No. 3 Froelich "F"

Company Kewanee Oil

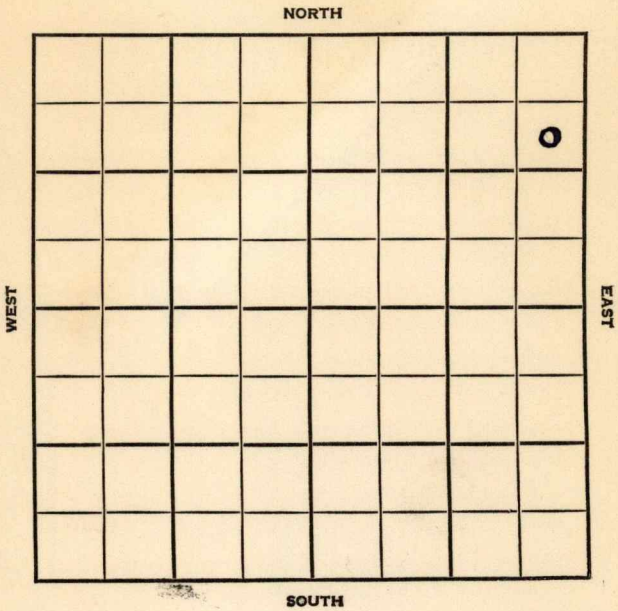

Ellis KANSAS


SEC. 34 TWP. 12 R. 16W

WELL NO. 3 Froelich "F" FARM

COMPANY Kewanee Oil

CONTRACTOR Lewis-  
NE Emmeram Pool

960 Ft. from N. Line  
 Ft. from S. Line  
 330 Ft. from E. Line  
 330 Ft. from W. Line

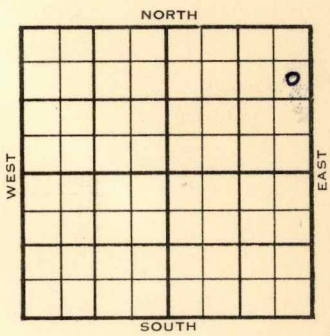

SE NE NE

1954 ELEVATION 2052' REPORT

8/4 Spdg 7-31-54  
 10" @ 267  
 WOC

10/27 Spud 7-31-54 - Oil Well  
 TD 3529'  
 10" @ 267'  
 Top 2954', Heeb 3214', Dodge 3241',  
 Lans 3263', Arb. 3 515'  
 TD 3529'  
 7" @ 3 517'  
 CO to 3529'  
 FU 1000' oil 7 3/4 hrs.,  
 S/106 bo 7 1/2 hrs.  
 Sd-oil-frac 500A  
 S/60 bo 120 bw 6 1/2 hrs.  
 P/55 bo 193 bw 20-2/3 hrs.  
 Comp. 55 bopd 193 bw

**COMPLETED**



