FORM 51 10M 2-49 PETROL

KANSAS


Barton

Section 11 Township 17 Range 11W

Well No. 1 Krantwerst (A) (KGS DRL)

Company Brunson & Williams

Kraft&Prusa

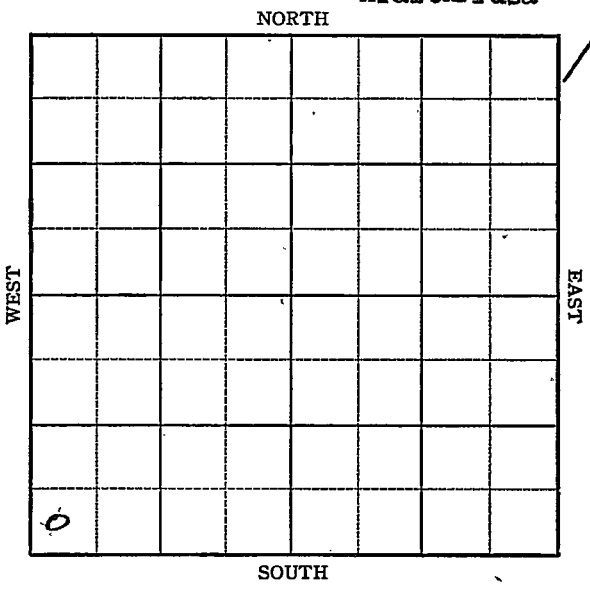

13

FORM 252-A
5M 10-48 PETROL

KANSAS ✓

Barton

Sec. 11 Twp. 17 R. 11W

Well No. #1 Krantworst (B) (KGS DRL) Farm

Bruns on & Williams Company

Kraft & Prusa Pool (Brunson & Williams, Cont)


_____ Ft. from N. Line

330' Ft. from S. Line

_____ Ft. from E. Line

330' Ft. from W. Line

SW/C

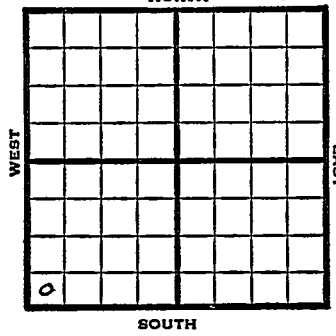

1949	Elev 1876' REPORT
8/3	RUR
8/10	8"@ 187' Drlg 2600'
8/17	Lansing 3041' Arb. 3328-30 TD 3330' 5"@ 3329'
8/24	TD 3331-2000' oil 12 hrs.
8/31	"
9/7	500 acid Pump 4½ bbls oil PH
9/14	SW/c
9/21	"
9/28	500 acid Pump 4½ BOPH
10/5	"
10/12	"
10/19	"
10/26	"
11/2	TD 3331' Arb. 3328' 5"@ 3329' 500 acid Pump 165 Oil Pot 42° Gr. Comp

COMPLETED

Form 26 200 Bks. 6-49 Petrol

Kansas

Kraft & Prusa Pool

Map No. _____ Sec. 11 Twp. 17 R. 11W


Well No. 1 Krantz West (B) (KGS DRL)

Brunson & Williams Company

Brunson & Williams Contractor

SW/C

FIRST REPORT
SECTION PLAT

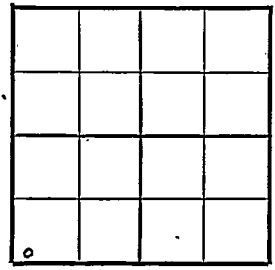

_____ Ft. from N. Line

330 Ft. from S. Line

_____ Ft. from E. Line

330 Ft. from W. Line

Barton County

Location _____

Rig up _____

Drilling and Remarks:

R U R

RECORD

Cased _____ in., _____ ft.

Sand _____

Gas _____

Oil _____

Total Depth _____

PRODUCTION

1st 24 hrs. Nat. _____

1st 24 hrs. after shot _____

Gas _____ Cu. Ft.

Dry Hole _____

Abandoned _____

Date

AUG 3 1949 19

S. J. LEWIS Scout

Form 26 200 Bks. 6-49 Petrol

Kansas

Kraft-Prusa Pool

Map No. _____ Sec. 11 Twp. 17 R. 11W

Well No. 1 Krautwurst "B" (KGS WRL)


Brunson & Williams Company

COMPLETE Contractor

SW/C

El. 1876

SECTION PLAT

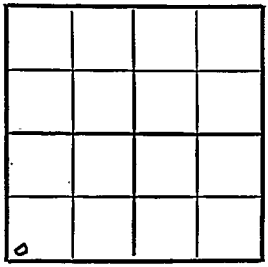

_____ Ft. from N. Line

330 Ft. from S. Line

_____ Ft. from E. Line

330 Ft. from W. Line

Barton County

Location _____

Rig up _____

Drilling and Remarks:

Ran 3328'

5" @ 3328'

Tobacco

Pump 165 bbl Bbl

420 Gas

RECORD

Cased _____ in., _____ ft.

Sand _____

Gas _____

Oil _____

Total Depth 3328'

PRODUCTION

1st 24 hrs. Nat. _____

1st 24 hrs. after shot _____

Gas _____ Cu. Ft.

Dry Hole _____

Abandoned _____

Date

NOV 2 1949 19

S. J. LEWIS Scout