


Barton

Section 11 Township 17 Range 11-W

Well No. 1 Krautwurst

Company Phillips

13

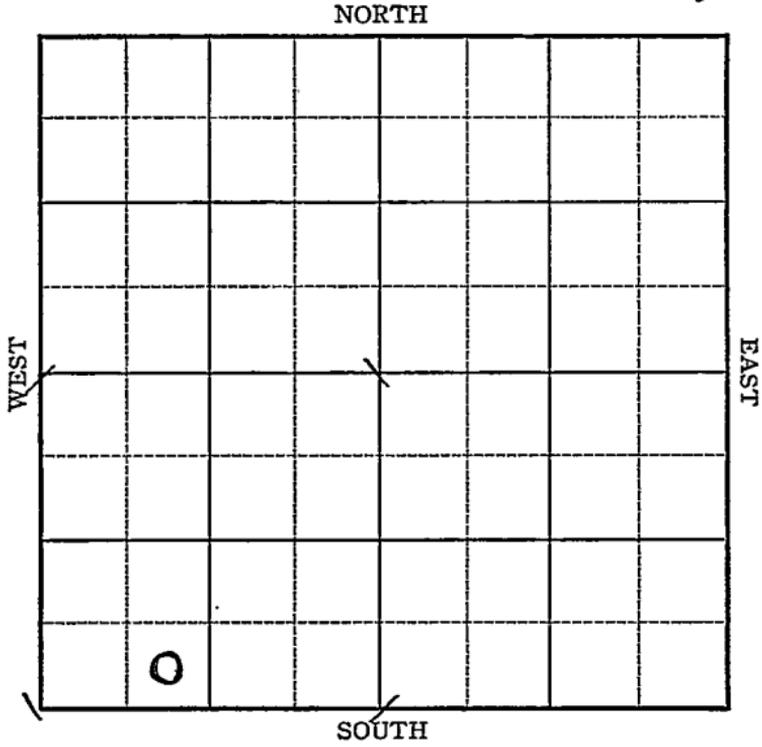

Sec. 11 Twp. 17 R. 11-W

Well No. #1 Krautwurst Farm

Phillips Company


\_\_\_\_\_ Ft. from N. Line

330 Ft. from S. Line

\_\_\_\_\_ Ft. from E. Line

990 Ft. from W. Line

Elev. 1885

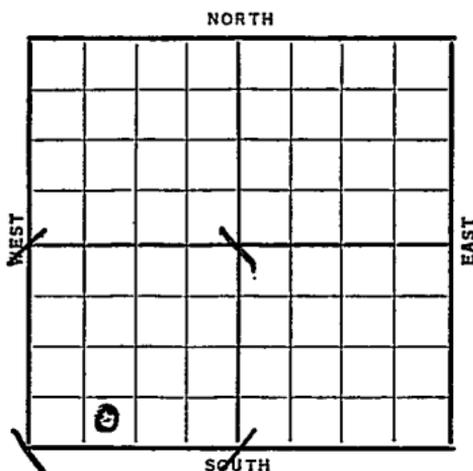

Date	REPORT
1937	
11/3	Cellar.
11/12	"
11/19	"
11/26	"
12/3	R. R.
12/10	10" @ 486'. WOC.
12/17	Drlg. 2395'.
12/24	Drlg. 3348'.
12/31	Arb. 3379'. Drlg. 3545'.
	No shows.
1938	
1/7	T.D. 3616'. No shows. S.D.O.
1/14	" " " " "
1/19	Arb. 3379'.
	T.D. 3616'.
	No shows.
<b>ABANDONED</b>	

Barton **KANSAS**Map No. \_\_\_\_\_ Sec. 11 Twp. 17 R11WWell No. 1 KrautwurstPhillips Company


Contractor

**FIRST REPORT****SECTION PLAT****SE SW SW**

\_\_\_\_\_ Ft. from N. Line

330 Ft. from S. Line

\_\_\_\_\_ Ft. from E. Line

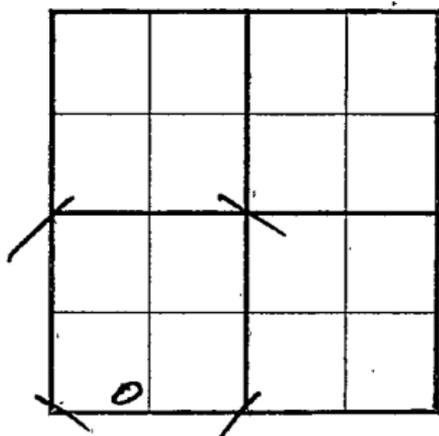990 Ft. from W. Line

Location \_\_\_\_\_

Rig up \_\_\_\_\_

Drilling and Remarks:

**Cellar****RECORD**

Cased \_\_\_\_\_ in., \_\_\_\_\_ ft.

Sand \_\_\_\_\_

Gas \_\_\_\_\_

Oil \_\_\_\_\_

Total Depth \_\_\_\_\_

**PRODUCTION**

1st 24 hrs. Nat. \_\_\_\_\_

1st 24 hrs. after shot \_\_\_\_\_

Gas \_\_\_\_\_ Cu. Ft.

Dry Hole \_\_\_\_\_

Abandoned \_\_\_\_\_

Date

NOV 3 1937

19

H. D. Hatfield

Scout

Barton KANSASMap No. 55 Sec. 11 Twp. 17 R. 11WWell No. 1 KrautwurstPhillips

Company

Contractor

ABANDONED

SE SW SW

SECTION PLAT

0			

\_\_\_\_\_ Ft. from N. Line

330 Ft. from S. Line

\_\_\_\_\_ Ft. from E. Line

990 Ft. from W. Line

Location \_\_\_\_\_

Rig up \_\_\_\_\_

Drilling and Remarks:

*No Shows**DVA*

## RECORD

Cased \_\_\_\_\_ in., \_\_\_\_\_ ft.

~~Sand~~ *Arb 3379*

Gas \_\_\_\_\_

Oil \_\_\_\_\_

Total Depth 3616

## PRODUCTION

1st 24 hrs. Nat. \_\_\_\_\_

1st 24 hrs. after shot \_\_\_\_\_

Gas \_\_\_\_\_ Cu. Ft.

Dry Hole \_\_\_\_\_

Abandoned \_\_\_\_\_

Date

JAN 19 1938 19H. D. Hatfield Scout