


Section 35 Township 12 Range 16W

Well No. 1 Sitz "B"

Company Kewanee Oil

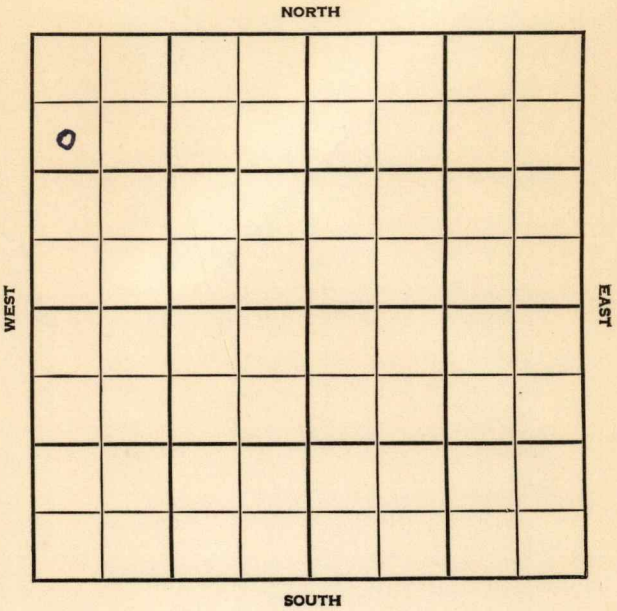

Ellis

KANSAS

SEC.	TWP.	R.
35	12	16 W

WELL NO.

1 Sitz "B"

FARM

COMPANY

Kewanee Oil

CONTRACTOR

Wentworth

NE Ammeron Pool

990

Ft. from N. Line


Ft. from S. Line

Ft. from E. Line

330

Ft. from W. Line

SW NW NW

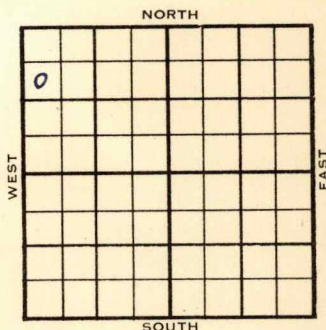

1954

ELEVATION

2015'

REPORT

10/27

Spud 10-16-54 10" @ 272

Anhy 1165' Top. 2925'

Drlg. 3161'

1955

1/26

Spud 10-16-54 - Oil Well

TD 3496'

10" @ 272'

Anhy 1165', Top. 2925', Heeb. 3176',

Dodge 3197', Lans. 3226'

DST 3291-3330', opn 1½ hrs., rec. 377'

O&GCM, 10' muddy wtr., 720#

Arb. 3487'

TD 3489'

7" @ 3488'

DD 3496', 500A

S/10 bfph 2% oil 3410#

12/3380-86, 12/3358-64,

PB 3340'

88/3295-3317', 500A

S/5 bfph 62% wtr.

P/17.9 bo 117 bwpd

PB 3316', 16/3308-12, 16/3296-3300,

4500A

/38 bo 11 baw 21 hrs.

P/20 bopd

Comp. 25 bopd

COMPLETED

County **Ellis** State **Kansas**Sec. **35** (Blk.) **12** (Sur.) **16W** Map No.Operator **Kewanee Oil**Well No. **1** Farm **Sitz "B"**Elev. **2015** Location **SW NW NW**

o							

990 Ft. From **N** Line **NW**330 Ft. From **W** Line Quarter1st. Report **OCT 27 1954**

Completion

Remarks

Wentworth - Contr.Spudding Date **10-16-54**Drlg. Data **NE Ammeron Pool****10" @ 272 Anhy 1165 Top. 2925****drlg. 3161**

FABEN GILSTRAP

County Ellis State KansasSec. 35 (Blk.
Twps.) 12 (Sur.
Rge.) 16W Map No. _____Operator Kewanee OilWell No. 1 Farm Sitz "B"Elev. 2015 Location SW NW NW990 Ft. From N Line NW330 Ft. From W Line Quarter1st. Report JAN 2 6 1955

Completion _____

Remarks NE Ammeron PoolWentworth - Contr.Spudding Date 10-16-54Drlg. Data Oil well TD 349610" @ 272 Anhy 1165 Top. 2925Heeb. 3176 Dodge 3197 Lans. 3226DST 3291-3330 open 1½ hr. Rec. 377' o &gcm 10' muddy wtr. 720# Arb. 3487TD 3489 7" @ 3488 DD 3496 500 AS/ 10 bfph 2% oil 3410# 12/ 3380-8612/ 3358-64 PB 3340 88/ 3295-3317500 A S/ 5 bfph 62% wtr.P/ 17.9 bo 117 bwpd PB 331616/ 3308-12 16/ 3296-3300 4500 AS/ 38 bo 11 baw 21 hr. P/ 20 bopdComp. 25 bopd

FABEN GILSTRAP