

# KANSAS

Form 51-5M-7-40-Palace


Barton

Section 11 Township 17 Range 11-W

Well No. #3 Hogan

Company Carter Oil

NORTH Kraft Pool

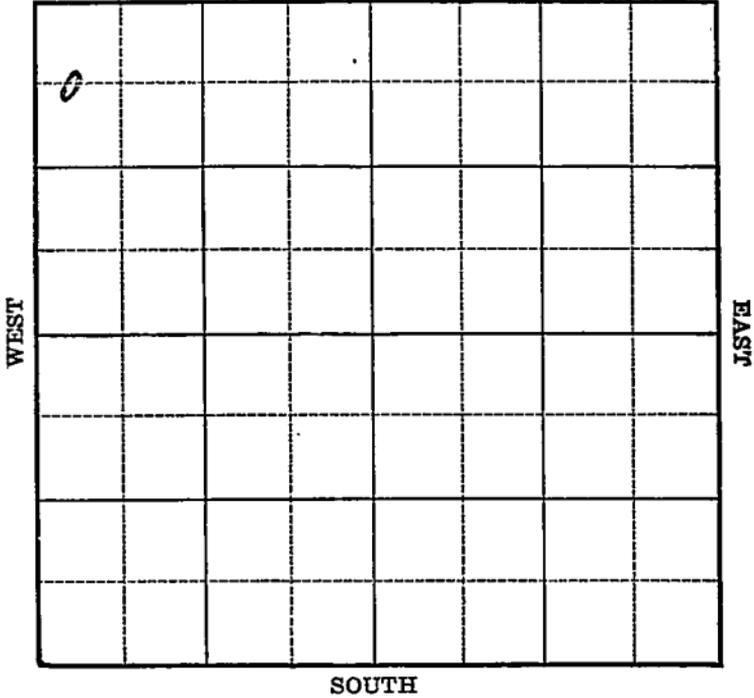



1941

1/8

Arb. 3331'

5" - 3332'

T.D. 3355'

2000 acid.

Depthograph 1158 bbls., fluid,

394 oil & 764 water.

43.6 Gravity

COMPLETED

Map No. 55 Sec. 11 Twp. 17 R. 11WWell No. 3 HoganCarter Oil

Company

Contractor

FIRST REPORT  
C W L NW NW

## SECTION PLAT

660 Ft. from N. Line

\_\_\_\_\_ Ft. from S. Line

\_\_\_\_\_ Ft. from E. Line

330 Ft. from W. Line


KRAFT POOL

Location X

Rig up \_\_\_\_\_

Drilling and Remarks:

## RECORD

Cased \_\_\_\_\_ in., \_\_\_\_\_ ft.

Sand \_\_\_\_\_

Gas \_\_\_\_\_

Oil \_\_\_\_\_

Total Depth \_\_\_\_\_

## PRODUCTION

1st 24 hrs. Nat. \_\_\_\_\_

1st 24 hrs. after shot \_\_\_\_\_

Gas \_\_\_\_\_ Cu. Ft.

Dry Hole \_\_\_\_\_

Abandoned \_\_\_\_\_

Date

NOV 6 1940 19\_\_\_\_S. J. LEWIS Scout

Map No. 55 Sec. 11 Twp. 17 R. 11W

Well No. 3 Hogan

Carter Oil Company

Contractor

**COMPLETED**

**SECTION PLAT**

C W L NW NW

660 Ft. from N. Line

\_\_\_\_\_ Ft. from S. Line

\_\_\_\_\_ Ft. from E. Line

330 Ft. from W. Line

6			

**KRAFT POOL**

Location \_\_\_\_\_

Rig up \_\_\_\_\_

Drilling and Remarks:

*Cor & 3331*  
*5" @ 3332*  
*2000 acid*  
*Depth 1158 Fluid*  
*394 oil 764 Water*  
*P.Y.*  
*43 1/2 yr*

**RECORD**

Cased \_\_\_\_\_ in., \_\_\_\_\_ ft.

Sand \_\_\_\_\_

Gas \_\_\_\_\_

Oil \_\_\_\_\_

Total Depth 3355

**PRODUCTION**

1st 24 hrs. Nat. \_\_\_\_\_

1st 24 hrs. after shot \_\_\_\_\_

Gas \_\_\_\_\_ Cu. Ft.

Dry Hole \_\_\_\_\_

Abandoned \_\_\_\_\_

Date

JAN 8 1941

S. J. LEWIS Scout