
KANSAS

Form 51-5M 5-37 Petrol Barton

Section 11 Township 17 Range 11-W

Well No. 2 Kroutwurst

Company Phillips Petroleum 12

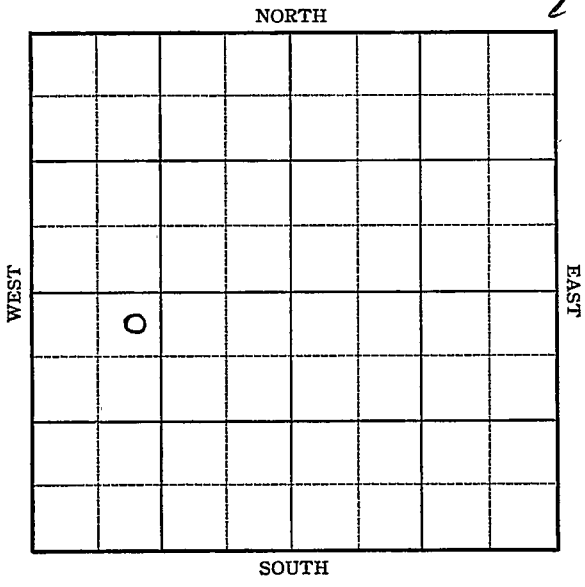

Form 252-A—5M—9-37 KANSAS Barton

Sec. 11 Twp. 17 R. 11-W

Well No. #2 Kroutwurst Farm


Phillips Petr. Company

330 Ft. from N. Line

Ft. from S. Line

Ft. from E. Line

990 Ft. from W. Line

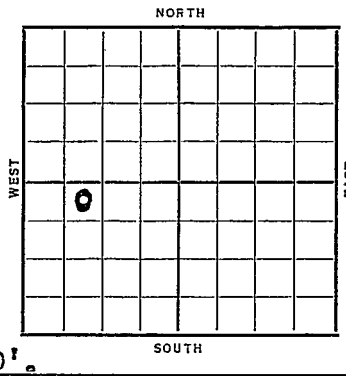

Elev. 1890'.

Date	REPORT
1938	
1/12	R U R
1/20	10" - 489' WOC
1/28	Drlg. 2550'.
2/4	Cong. 3314' Drlg. 3340'
2/9	Arb. 3351'.
	T.D. 3364'.
	ABANDONED

Form 26—1M Bks.—2-29

Barton KANSAS

Map No. 55 Sec. 11 Twp. 17 R 11W

Well No. 2 Kroutwurst

Phillips Petroleum Company

Contractor

FIRST REPORT

NE NW SW


330 Ft. from N. Line

____ Ft. from S. Line

____ Ft. from E. Line

990 Ft. from W. Line

SECTION PLAT

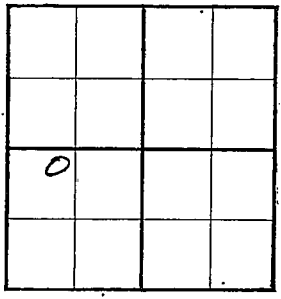

Location ____

Rig up ____

Drilling and Remarks:

RUR

RECORD

Cased ____ in., ____ ft.

Sand ____

Gas ____

Oil ____

Total Depth ____

PRODUCTION

1st 24 hrs. Nat. ____

1st 24 hrs. after shot ____

Gas ____ Cu. Ft.

Dry Hole ____

Abandoned ____

Date

JAN 12 1938 19 H. D. Hatfield Scout

Form 26—1M Bks.—2-29

Barton KANSAS

Map No. · Sec. 11 Twp. 17 R. 11W

Well No. 2 Kroutwurst

Phillips Company

Contractor

ABANDONED

NE NW SW


330 Ft. from N. Line

Ft. from S. Line

Ft. from E. Line

990 Ft. from W. Line

SECTION PLAT

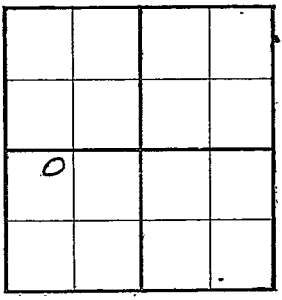

Location

Rig up

Drilling and Remarks:

D X A

RECORD

Cased in., ft.

~~Sand~~ Arb 3351

Gas

Oil

Total Depth 3364

PRODUCTION

1st 24 hrs. Nat.

1st 24 hrs. after shot

Gas Cu. Ft.

Dry Hole

Abandoned

Date

FEB 9 1938 19

H. D. Hatfield Scout