


KANSAS

FORM 51 5M 4-41 PETROL **Barton**

Section 11 Township 17 Range 11-W

Well No. 3 Hogan

Company Cities Service Oil

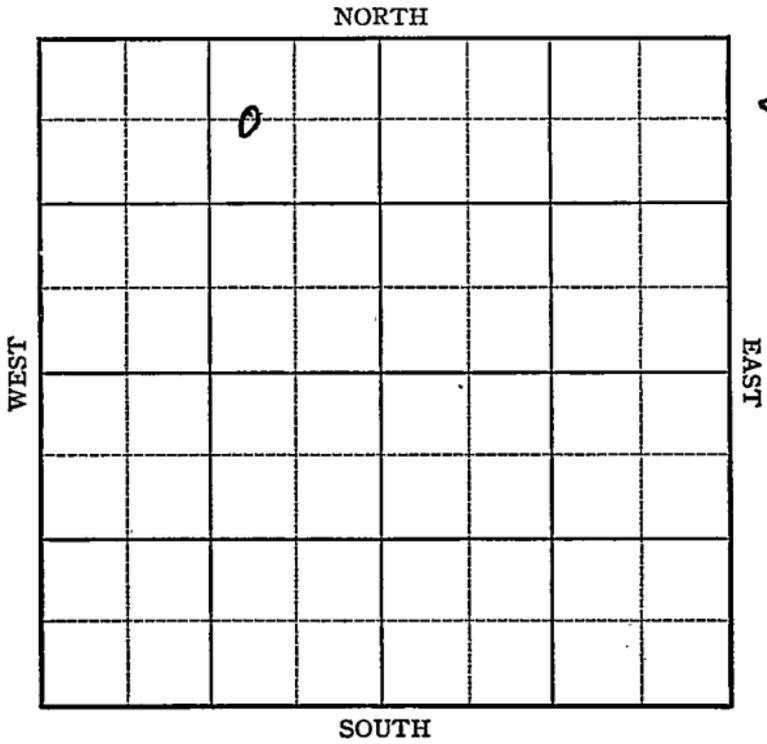

Sec. 11 Twp. 17 R. 11-W

Well No. #3 Hogan Farm

Cities Service Oil Company


(Kraft)

660 Ft. from N. Line

_____ Ft. from S. Line

990 Ft. from E. Line

_____ Ft. from W. Line

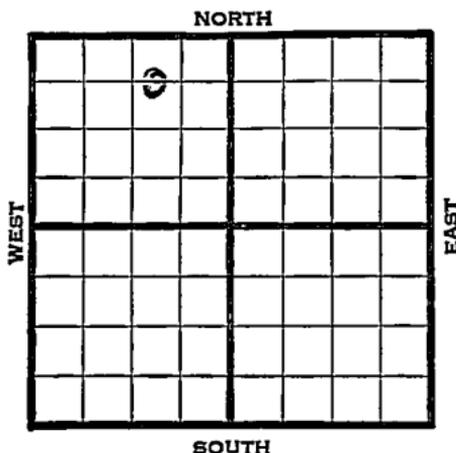

Elev. 1922

1941	REPORT
7/9	Location
7/17	"
7/24	"
7/31	"
8/7	Rotary
8/15	8" - 395' WOC
8/21	Drilg. 3076'
8/28	Lans. 3075' Arb. 3352'
	5" - 3353' T.D. 3361'
	2600' oil 5 hours.
9/4	2000 acid.
9/10	Arb. 3353'
	5" - 3353'
	T.D. 3361'
	2000 acid.
	Echometer potential 6148 bbls.
	Maximum 3000 bbls.
	43.6 Gravity
	COMPLETED

Map No. _____ Sec. 11 Twp. 17 R. 11WWell No. 3 HoganCities Service Oil Company

Contractor _____

FIRST REPORT

C W L NE NW

660 Ft. from N. Line

_____ Ft. from S. Line

990 Ft. from E. Line

_____ Ft. from W. Line

KRAFT POOL

SECTION PLAT

	o		

Location X

Rig up _____

Drilling and Remarks:

RECORD

Cased _____ in., _____ ft.

Sand _____

Gas _____

Oil _____

Total Depth _____

PRODUCTION

1st 24 hrs. Nat. _____

1st 24 hrs. after shot _____

Gas _____ Cu. Ft.

Dry Hole _____

Abandoned _____

Date

JUL 9 194119S. J. LEWIS Scout

Barton

KANSAS

Map No. _____ Sec. 11 Twp. 17 R. 11WWell No. 3 HoganCities Service Oil CompanyCOMPLETED Contractor

SECTION PLAT

660 C W L NE NW
Ft. from N. Line

_____ Ft. from S. Line

990 Ft. from E. Line

_____ Ft. from W. Line

KRAFT POOL

Location _____

Rig up _____

Drilling and Remarks:

Cr 83353
5" @ 3353
2000 cu. ft.
Ech P 6148
Max 3000
436 Gr

RECORD

Cased _____ in., _____ ft.

Sand _____

Gas _____

Oil _____

Total Depth 3361

PRODUCTION

1st 24 hrs. Nat. _____

1st 24 hrs. after shot _____

Gas _____ Cu. Ft.

Dry Hole _____

Abandoned _____

Date

SEP 10 1941 19S. J. LEWIS Scout