

KANSAS Barton


FORM 51 IOM 12-46 PETROL

Section 13 Township 17 Range 11W

Well No. 5 Ehler

Company Eldorado Ref. Co.

16

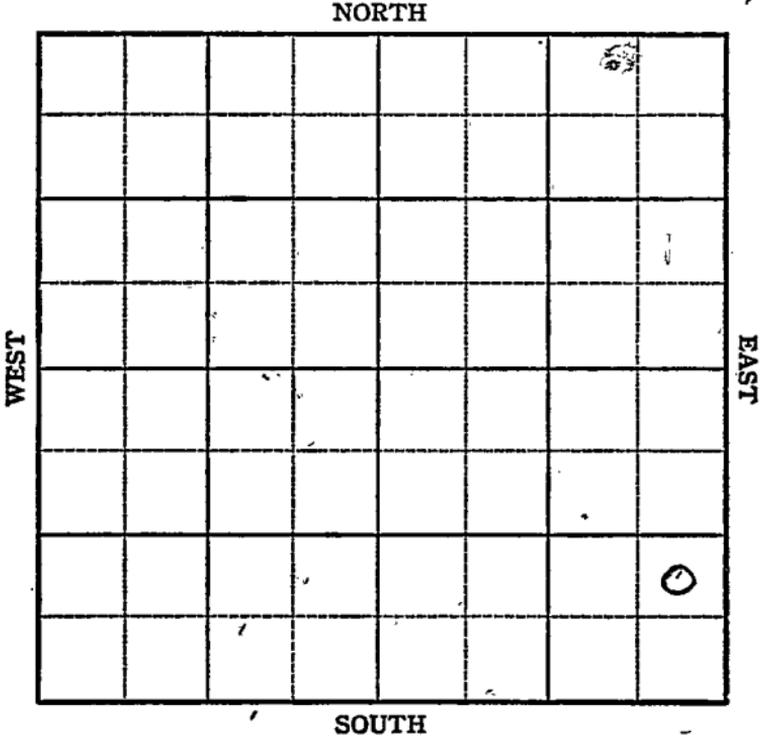

KANSAS

Barton county



Sec. 11

Twp. 17

R. 11W

Well No. 5 Ehler Farm

Eldorado Ref. Company


Kraft-Prusa

_____ Ft. from N. Line

990 Ft. from S. Line

330 Ft. from E. Line

_____ Ft. from W. Line

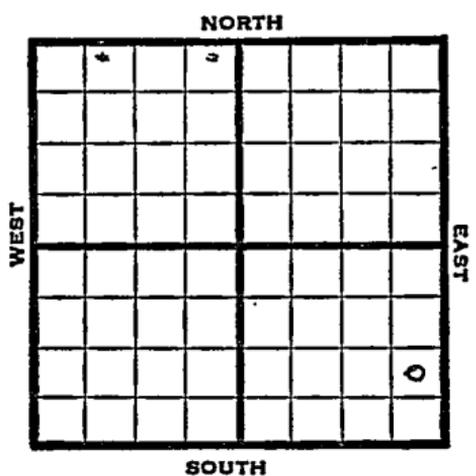

NE SE SE

1947 Elev. 1901' REPORT

- 5/28 Location
- 6/3 8" @ 250 WOC
- 6/10 Lansing 3060
Drlg. 3277'
- 6/17 Arbuckle 3362-68 TD
5" @ 3362
500 acid
- 6/24 T.D. 3377'
20 qts 3363-73
2000 acid
swb 1 oil & 1/2 water PH
- 7/1 " " "
- 7/8 " " "
- 7/16 TD 3377'
- 7/22 "

OVER

1947

7/30

Arb. 3362'
5" @ 3362'
500 Acid .
Pump 71 Pot
42.0 Gr.
TD 3377'

COMPLETED

Map No. _____ Sec. 11 Twp. 17 R. 11W

Well No. 5 Ehler

_____ Eldorado Ref. _____ Company

FIRST REPORT _____ Contractor

NE SE SE

SECTION PLAT

_____ Ft. from N. Line

990 Ft. from S. Line

330 Ft. from E. Line

_____ Ft. from W. Line

			o

Barton County

Location _____

Rig up _____

Drilling and Remarks: _____

RECORD

Cased _____ in., _____ ft.

Sand _____

Gas _____

Oil _____

Total Depth _____

PRODUCTION

1st 24 hrs. Nat. _____

1st 24 hrs. after shot _____

Gas _____ Cu. Ft.

Dry Hole _____

Abandoned _____

Date

MAY 28 1947 19

S. J. LEWIS

Scout

Map No. 55 ^{Kansas} Sec. 11 Twp. 17 R. 11W

Well No. 5 Ehler

Eldorado Ref. Company

COMPLETE Contractor
NE SE SE E. 191

SECTION PLAT

			0

 Ft. from N. Line
990 Ft. from S. Line
330 Ft. from E. Line
 Ft. from W. Line

Barton County

RECORD

Location

Cased in., ft.

Rig up

Sand

Drilling and Remarks:

Gas

Per 43362

Oil

5" @ 8262

Total Depth 2277

500 acid

Run 7/1/47

PRODUCTION

1st 24 hrs. Nat.

1st 24 hrs. after shot

Gas Cu. Ft.

Dry Hole

Abandoned

42 2/4

Date

JUL 30 1947 19

S. J. LEWIS

Scout