


Section 11 Township 17 Range 11-W

Well No. #5 Hogan "A"

Company Cities Service Oil

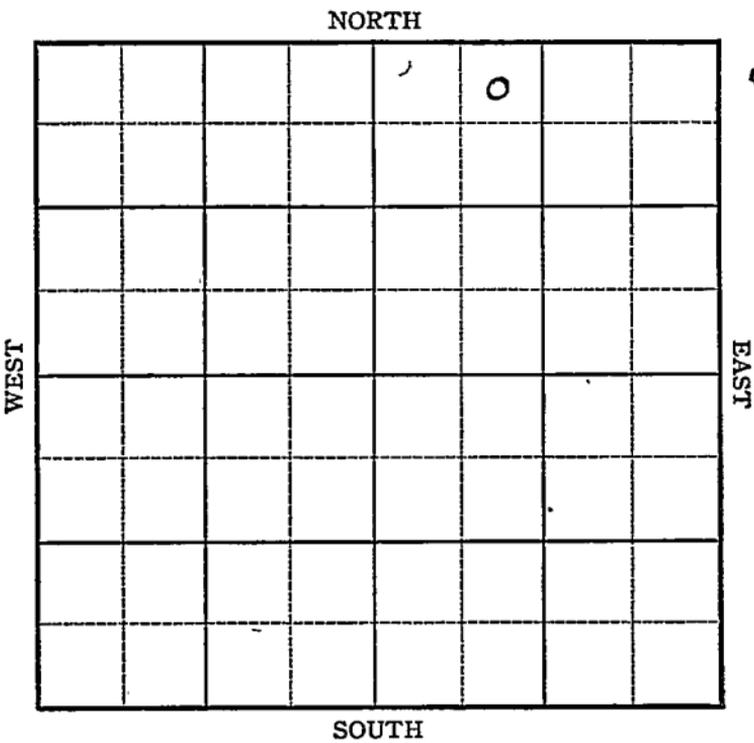

Sec. 11 Twp. 17 R. 11-W

Well No #5 Hogan "A" Farm

Cities Service Oil Company

Kraft


330 Ft. from N. Line

\_\_\_\_\_ Ft. from S. Line

\_\_\_\_\_ Ft. from E. Line

990 Ft. from W. Line

*pled. 1949*

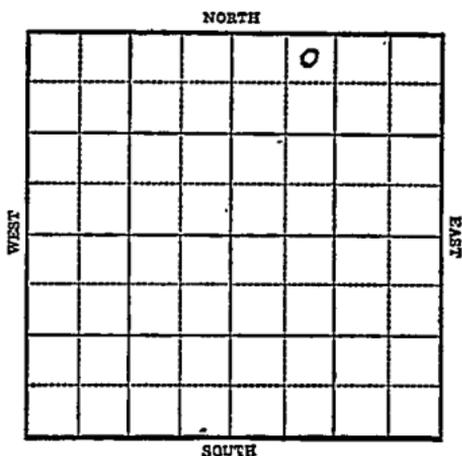

1943

R E P O R T

4/28 Rotary.

5/5 8" @ 245  
Drlg. 764'

5/12 Drlg. 3332'

5/19 Lans 3096  
Arb 3372  
5" @ 3374  
T.D. 3393  
2950' oil 10 hrs.

5/26 Arb. 3372  
5" @ 3374'  
T.D. 3393'  
Pump 455 Pot.  
Gravity 43.8

**COMPLETED**

KANSAS

Barton

Map No. 55 Sec. 11 Twp. 17 R. 11WWell No. 5 Hogan "A"Cities Service Oil

Company

FIRST REPORT

Contractor

NE NW NE

## SECTION PLAT

330 Ft. from N. Line

\_\_\_\_\_ Ft. from S. Line

\_\_\_\_\_ Ft. from E. Line

990 Ft. from W. Line

			0

KRAFT PRUSA POOL

Location \_\_\_\_\_

Rig up \_\_\_\_\_

Drilling and Remarks:

Rotary

## RECORD

Cased \_\_\_\_\_ in., \_\_\_\_\_ ft.

Sand \_\_\_\_\_

Gas \_\_\_\_\_

Oil \_\_\_\_\_

Total Depth \_\_\_\_\_

## PRODUCTION

1st 24 hrs. Nat. \_\_\_\_\_

1st 24 hrs. after shot \_\_\_\_\_

Gas \_\_\_\_\_ Cu. Ft.

Dry Hole \_\_\_\_\_

Abandoned \_\_\_\_\_

Date

APR 28 1943

19

S. J. LEWIS Scout

Barton

KANSAS

Map No. 55 Sec. 11 Twp. 17 R. 11WWell No. 5 Hogan "A"Cities Service Oil Company**COMPLETED**

Contractor

NE NW NE

## SECTION PLAT

330 Ft. from N. Line

\_\_\_\_\_ Ft. from S. Line

\_\_\_\_\_ Ft. from E. Line

990 Ft. from W. Line

			0

KRAFT PRUSA POOL

Location \_\_\_\_\_

Rig up \_\_\_\_\_

Drilling and Remarks:

*Cor 83372**5" @ 3374**Pump 455**43 1/2*

## RECORD

Cased \_\_\_\_\_ in., \_\_\_\_\_ ft.

Sand \_\_\_\_\_

Gas \_\_\_\_\_

Oil \_\_\_\_\_

Total Depth 3372

## PRODUCTION

1st 24 hrs. Nat. \_\_\_\_\_

1st 24 hrs. after shot \_\_\_\_\_

Gas \_\_\_\_\_ Cu. Ft.

Dry Hole \_\_\_\_\_

Abandoned \_\_\_\_\_

Date

MAY 26 1943

19

S. J. LEWIS Scout