
FORM 51 25M 8-50 WESTERN Barton KANSAS

Section 11 Township 17 Range 11W

Well No. #5 Krautwurst "A"

Company Okla.-Texas Trust Operating Div.

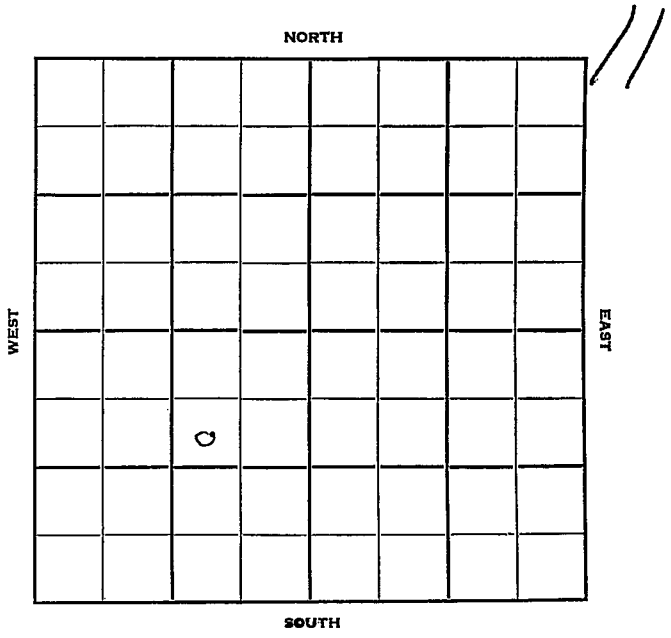

FORM 252-B
10M 8-51 TPCO.

Barton KANSAS

Sec. 11 Twp. 17 R. 11W

Well No. #5 Krautwurst "A" (Was R.L. Williams) Farm

Okla.-Texas Trust Oper. Division Company

H. M. Williams - Contr. Contractor

Kraft-Prusa Pool


990' Ft. from N. Line

Ft. from S. Line

990' Ft. from E. Line

Ft. from W. Line

SW NE SW

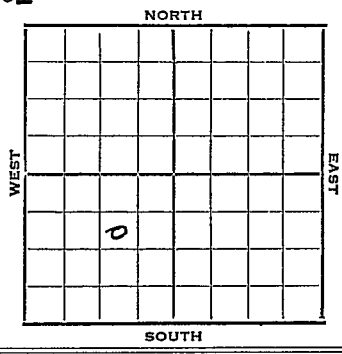

1951	Elev. 1903' REPORT
12/12	Spud 12-9-51 8-5/8" @ 303 WOC
1952 1/16	Spud 12-9-51 D&A TD 3371' 8-5/8" @ 303 Top. 2697 Heeb. 2939 Br. Li 3041 Lans. 3055 Cong. 3336 Arb. 3367-71 TD D&A

ABANDONED

FORM 275 FOR SALE BY KANSAS BLUE PRINT CO.


County Barton State Kansas

Sec. 11 (Blk. Twp.) 17 (Sur. Rge.) 11W Map No.

Operator Okla. - Texas Trust Operating Division

Well No. 5 Farm Krautwurst "A" (was R.L. Williams)

Elev. Location SW NE SW

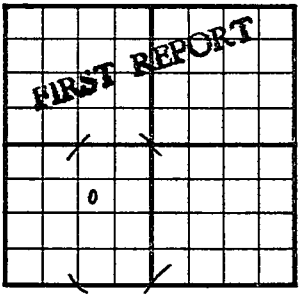

990 Ft. From N Line SW

990 Ft. From E Line Quarter

1st. Report DEC 12 1951

Completion

Remarks

H.M. Williams - Contr.

Spudding Date 12-9-51

Drlg. Data Kraft-Prusa Pool

8 5/8" @ 303 WOC

J. E. TYRA

FORM 275 FOR SALE BY KANSAS BLUE PRINT CO.


County Barton State Kansas

Sec. 11 (Blk. Twp.) 17 (Sur. Rge.) 11W Map No.

Operator Okla.-Texas Trust Operating Division

Well No. 5 Farm Krautwurst "A"

Elev. 1903 Location SW NE SW

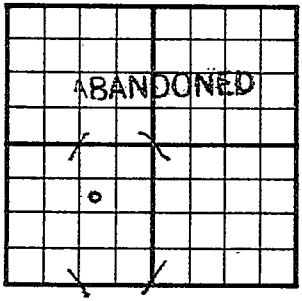

990 Ft. From N Line SW

990 Ft. From E Line Quarter

1st. Report

Completion JAN 1 6 1952

Remarks Kraft-Prusa Pool

H.M. Williams - Contr.

Spudding Date 12-9-51

Drlg. Data D & A TD 3371

8 5/8" @ 303 Top. 2697 Heeb. 2939

Br. lime 3041 Lans. 3055 Cong. 3336

Arb. 3367-71 TD

D & A

J. E. TYRA