

Woodson


Form 51-5M-2-29-34703

Map No. KANSAS Sec. 3 Twp. 24 R. 14

Well No. 1- Lock Farm

Brothers Oil Company

NORTH

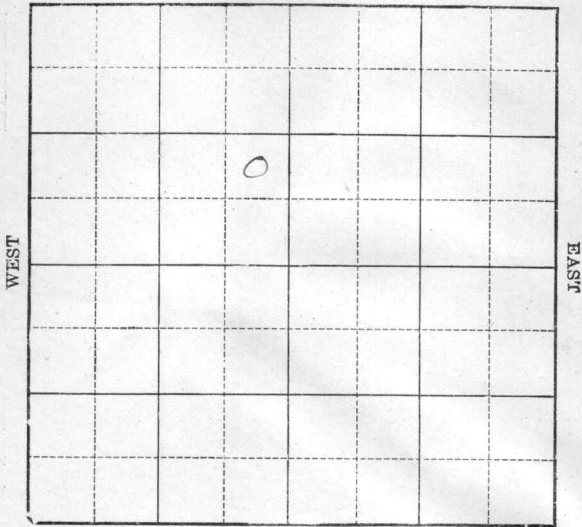

SOUTH

Location \_\_\_\_\_

Drilling Remarks \_\_\_\_\_

Rig Up \_\_\_\_\_

Drilling Remarks \_\_\_\_\_

RECORD

Cased \_\_\_\_\_ in. \_\_\_\_\_ ft.

Sand \_\_\_\_\_

Gas \_\_\_\_\_

Oil \_\_\_\_\_

Total Depth \_\_\_\_\_

PRODUCTION

1st 24 hrs. Nat. \_\_\_\_\_

1st 24 hrs. after shot \_\_\_\_\_

Gas \_\_\_\_\_ cu. ft. \_\_\_\_\_

Dry Hole \_\_\_\_\_

Abandoned \_\_\_\_\_

State \_\_\_\_\_ County Woodson  
 Sec. 3 Twp. 24 N-S; Rge. 14 E-W  
 Well No. 1 Lock Farm \_\_\_\_\_  
Brothers Oil Co Company

NORTH

			0				

WEST

EAST

FIRST REPORTS

ABANDONED

SOUTH

Location \_\_\_\_\_ Cased \_\_\_\_\_ in. \_\_\_\_\_ ft.  
 Rig up \_\_\_\_\_ Mach \_\_\_\_\_ Productive Horizons  
 From \_\_\_\_\_ To \_\_\_\_\_  
 Drilling at Sand Hill 1748-1750  
 Fishing at D & G 1750  
 U. R. to \_\_\_\_\_  
 S. D. at \_\_\_\_\_  
 Natural production \_\_\_\_\_ Bbbs. per \_\_\_\_\_ hours  
 Pumping \_\_\_\_\_ Gas \_\_\_\_\_ Cu. ft. per 24 hours  
 Gauge press. \_\_\_\_\_ lbs. Total depth \_\_\_\_\_  
 Were samples collected \_\_\_\_\_  
 Remarks:

6/21/21

Sherwood