



Sec. 11 Twp. 17 R. 11W

Well No. #3 Krautwurst Farm

R. L. Williams Company

Kraft-Prusa Pool


Ft. from N. Line

990' Ft. from S. Line

330' Ft. from E. Line

Ft. from W. Line

NE SE SW

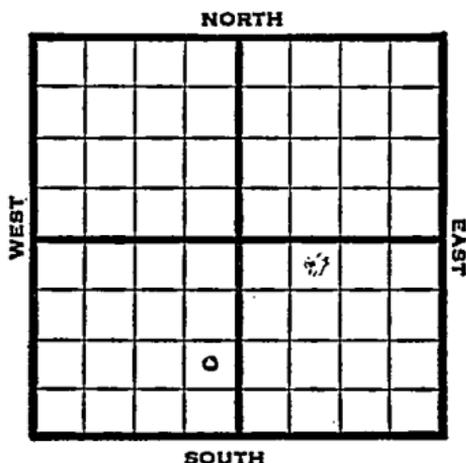

1948

Eli 1930'

REPORT

9/15

8" @ 252'

Anhy. 735'

Drlg. 2225'

9/21

"

9/29

Lansing 3089'

Arb. 3384'

5" @ 3386'

TD 3388' 4000 acid

10/6

"

10/13

"

10/19

"

10/26

Pump 10 bbls oil PH 24 hrs.

11/3

"

11/10

TD 3388'

Arb. 3384'

5" @ 3386'

400 acid

Pump 315 Oil / 2% W Pot

42° Gr.

Comp

COMPLETED

