

KANSAS

FORM 51 5M 2-38 TPCO.


Barton

Section 11 Township 17 Range 11-W

Well No. #3 Kroutwurst

Company Phillips

12

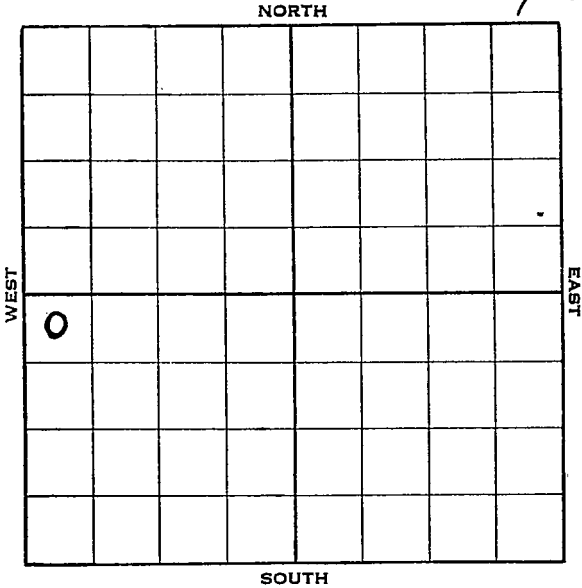

Well No. 70 Phillips Farm Phillips Company


330 Ft. from N. Line

Ft. from S. Line

_Ft. from E. Line

330 Ft. from W. Line

Elev. 1876

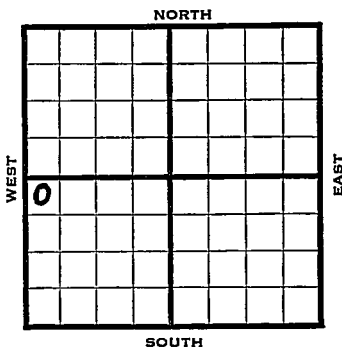[illegible]

Barton KANSAS

Map No. 55 Sec. 11 Twp. 17 R. 11WWell No. 3 KroutwurstPhillips

Company

Contractor

FIRST REPORT

NW SW

330 Ft. from N. Line Ft. from S. Line Ft. from E. Line330 Ft. from W. Line

SECTION PLAT

0			

Location

RECORD

Cased in., ft.Sand Gas Oil Total Depth Rig up

Drilling and Remarks:

RUR

PRODUCTION

1st 24 hrs. Nat. 1st 24 hrs. after shot Gas Cu. Ft.Dry Hole Abandoned

Date

AUG 10 1938 19

H. D. Hatfield Scout

Barton

KANSAS

Map No. 53 Sec. 11 Twp. 17 R. 11WWell No. 3 KroutwurstPhillips

Company

Contractor

NW SW

330 Ft. from N. Line Ft. from S. Line Ft. from E. Line330 Ft. from W. Line

SECTION PLAT

0			

Location Rig up

Drilling and Remarks:

No showsD & ANo pipe run
RECORDCased in., ft.Sand Arb 3378Gas Oil Total Depth 3390

PRODUCTION

1st 24 hrs. Nat. 1st 24 hrs. after shot Gas Cu. Ft.Dry Hole Abandoned

Date

SEP 21 1938

19

Scout

Hatfield
By: Paul