



Sec. 11 Twp. 17 R. 11-W

Well No. #4 Hogan Farm

Cities Service Oil Company

(Kraft)


660 Ft. from N. Line

\_\_\_\_\_ Ft. from S. Line

330 Ft. from E. Line

\_\_\_\_\_ Ft. from W. Line

Elev. 1939

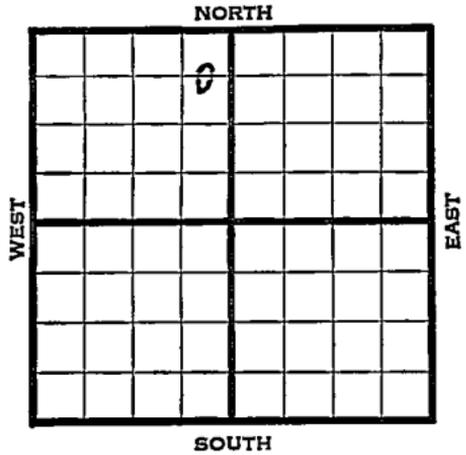

1941	REPORT
9/24	Derrick.
10/2	10" - 395' Drlg. 2440'
10/9	Fsg. 3321'
10/15	Arb. 3408'
	T.D. 3430'
	Water.
	ABANDONED

Map No. H-55 Sec. 11 Twp. 17 R. 11WWell No. 4 HoganCities Service Oil CompanyFIRST REPORT Contractor

C EL NE NW

660 Ft. from N. Line         Ft. from S. Line330 Ft. from E. Line         Ft. from W. Line

## SECTION PLAT

		0	

## KRAFT POOL

Location                                 Rig up                                 

Drilling and Remarks:

Derrick

## RECORD

Cased          in.,          ft.Sand                                 Gas                                 Oil                                 Total Depth                         

## PRODUCTION

1st 24 hrs. Nat.                         1st 24 hrs. after shot                         Gas                                  Cu. Ft.Dry Hole                                 Abandoned                                 

Date

SEP 24 1941

19

S. J. LEWIS Scout

Barton

KANSAS

Map No. K-55 Sec. 11 Twp. 17 R. 11WWell No. 4 HoganCities Service Oil CompanyABANDONED Contractor

C E L N E N W

660 Ft. from N. Line

\_\_\_\_\_ Ft. from S. Line

330 Ft. from E. Line

\_\_\_\_\_ Ft. from W. Line

## SECTION PLAT

		a	

KRAFT POOL

Location \_\_\_\_\_

Rig up \_\_\_\_\_

Drilling and Remarks:

*Cor + 3408**Water*

## RECORD

Cased \_\_\_\_\_ in., \_\_\_\_\_ ft.

Sand \_\_\_\_\_

Gas \_\_\_\_\_

Oil \_\_\_\_\_

Total Depth 3420

## PRODUCTION

1st 24 hrs. Nat. \_\_\_\_\_

1st 24 hrs. after shot \_\_\_\_\_

Gas \_\_\_\_\_ Cu. Ft.

Dry Hole \_\_\_\_\_

Abandoned \_\_\_\_\_

Date

OCT 15 1941 19S. J. LEWIS Scout