

KANSAS


FORM 51 5M 4-41 PETROL

Barton

Section 11 Township 17 Range 11-W

Well No. 4 Hogan

Company Carter Oil

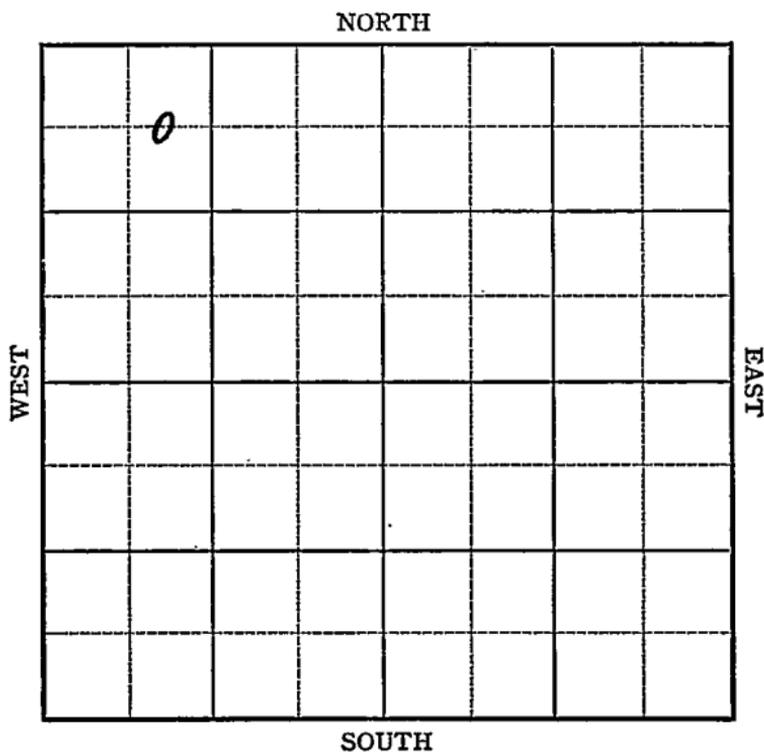

Sec. 11 Twp. 17 R. 11-W

Well No. #4 Hogan Farm

Carter Oil Company

(Kraft)


660 Ft. from N. Line

_____ Ft. from S. Line

_____ Ft. from E. Line

990 Ft. from W. Line

Elev. 1915

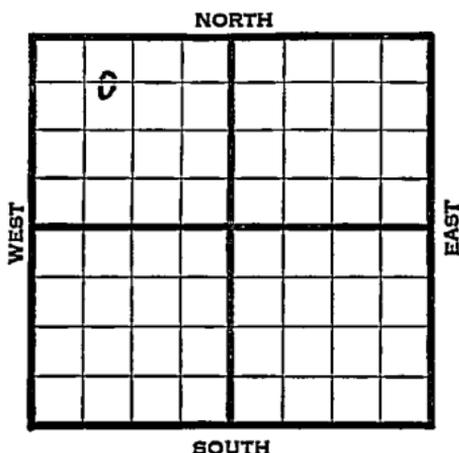

194

REPORT

7/9	Drlg. 234'
7/17	8" - 238' Drlg. 2923'
7/24	Lansing 3069 Arb 3337 5" @ 3336 200' oil 1 hr Drlg. 3345
7/30	Arb 3337'
	TD 3345'
	5" @ 3336'
	500 acid.
	Depth Potential. 2113 oil &
	642 Water
	43.6 Gravity

COMPLETED

Map No. _____ Sec. 11 Twp. 17 R. 11WWell No. 4 HoganCarter Oil Company

Contractor

FIRST REPORT

C E L NW NW

660 Ft. from N. Line

_____ Ft. from S. Line

_____ Ft. from E. Line

990 Ft. from W. Line

SECTION PLAT

o			

KRAFT POOL

Location _____

Rig up _____

Drilling and Remarks:

Drlg. 234

RECORD

Cased _____ in., _____ ft.

Sand _____

Gas _____

Oil _____

Total Depth _____

PRODUCTION

1st 24 hrs. Nat. _____

1st 24 hrs. after shot _____

Gas _____ Cu. Ft.

Dry Hole _____

Abandoned _____

Date

JUL 9 1941 19S. J. LEWIS Scout

Map No. _____ Sec. 11 Twp. 17 R. 11W

Well No. 4 Hogan

Carter Oil Company

Contractor

COMPLETED

SECTION PLAT

660 C E L NW NW
Ft. from N. Line

_____ Ft. from S. Line

_____ Ft. from E. Line

990 Ft. from W. Line

0			

KRAFT POOL

RECORD

Location _____

Cased _____ in., _____ ft.

Rig up _____

Sand _____

Drilling and Remarks:

Gas _____

Oil _____

Total Depth 3345

Cur 8837
5" @ 3336
500 acid
Depth 2113 oil
7642 Water

486 cu.

PRODUCTION

1st 24 hrs. Nat. _____

1st 24 hrs. after shot _____

Gas _____ Cu. Ft.

Dry Hole _____

Abandoned _____

Date

JUL 30 1941

S. J. LEWIS Scout