


KANSAS Barton

Section 11 Township 17 Range 11W

Well No. 6 Ehler "A"

Company Elderado Ref.

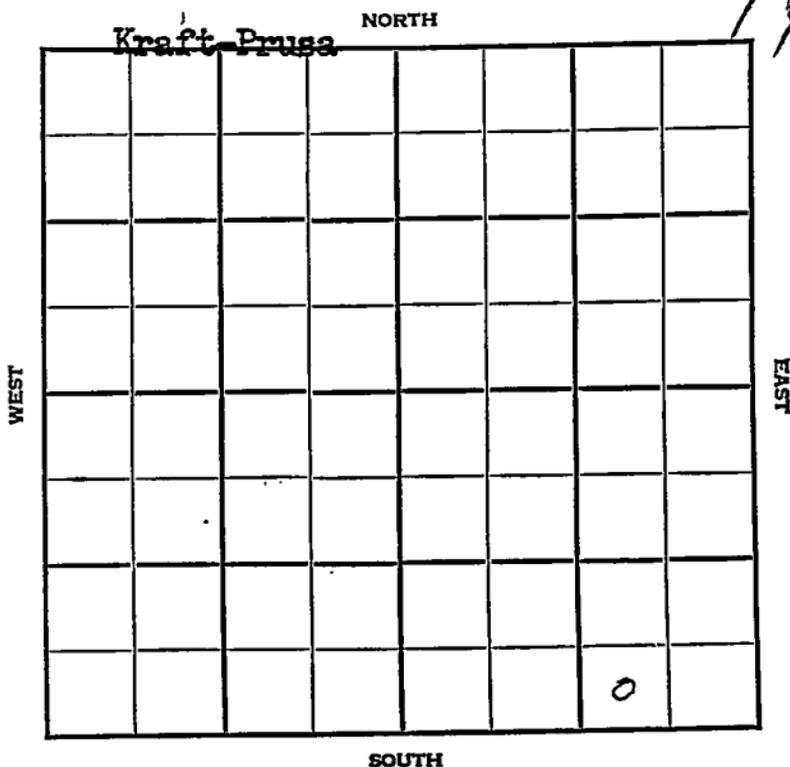

KANSAS

Barton

Sec. 11 Twp. 17 R. 11W ✓

Well No. #6 Ehler "A" Farm
Eldorado Ref. Company

Kraft-Prusa Pool


 Ft. from N. Line

330' Ft. from S. Line

990' Ft. from E. Line

 Ft. from W. Line

SW SE SE

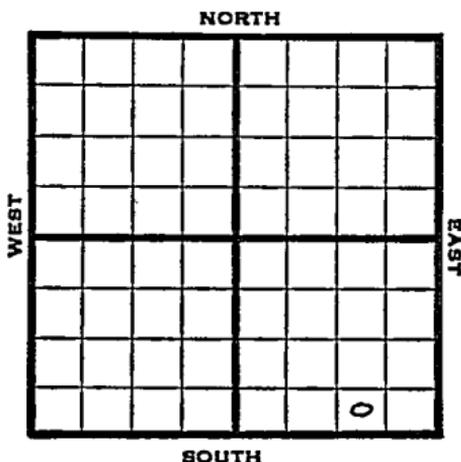

1948

Elev. 1896' REPORT

3/10

Location

3/17

"

3/24

"

3/31

"

4/7

8" @ 342'
Drlg. 1865'

4/14

Lansing 3045'
Drlg. 3181'

4/21

Arbuckle 3328'
TD 3331'
5" @ 3330'
RUST

4/28

TD 3348'
Swb. 13½ bbls. oil in 3 hrs.

5/5

"

5/12

Arb. 3328'
5" @ 3330'
Pump 132 Oil pot
42.0 Gr.
TD 3348'
Comp.

COMPLETED

Map No. _____ Sec. 11 Twp. 17 R. 11W

Well No. 6 Ehler "A"

Eldorado Ref. Company

FIRST REPORT

Contractor

SW SE SE

SECTION PLAT

| | | | |
|--|--|--|--|
| | | | |
| | | | |
| | | | |
| | | | |

_____ Ft. from N. Line

330 Ft. from S. Line

990 Ft. from E. Line

_____ Ft. from W. Line

Barton County

Location X

Rig up _____

Drilling and Remarks:

RECORD

Cased _____ in., _____ ft.

Sand _____

Gas _____

Oil _____

Total Depth _____

PRODUCTION

1st 24 hrs. Nat. _____

1st 24 hrs. after shot _____

Gas _____ Cu. Ft.

Dry Hole _____

Abandoned _____

Date

MAR 10 1948 19

S. J. LEWIS Scout

Map No. 55 Sec. 11 Twp. 17 R. 11W

Well No. 6 Ehler "A"

Eldorado Ref. Company

COMPLETE

Contractor

SW SE SE

E11896
SECTION PLAT

| | | | |
|--|--|--|--|
| | | | |
| | | | |
| | | | |
| | | | |

 Ft. from N. Line

330 Ft. from S. Line

990 Ft. from E. Line

 Ft. from W. Line

Barton County

Location

Rig up

Drilling and Remarks:

Cor & 3325

5" C3330

*Pump 132 oil
Pad*

42° S

RECORD

Cased in., ft.

Sand

Gas

Oil

Total Depth 3348

PRODUCTION

1st 24 hrs. Nat.

1st 24 hrs. after shot

Gas Cu. Ft.

Dry Hole

Abandoned

Date

MAY 12 1948

S. J. LEWIS Scout