



Woodson

KANSAS

Sec. 3 Twp. 24 R. 14E

Well No. #3 Lock Farm

E. Kilby

Company

Miscellaneous


200' Ft. from N. Line

\_\_\_\_\_ Ft. from S. Line

\_\_\_\_\_ Ft. from E. Line

750'  
\_\_\_\_\_ Ft. from W. Line

NE NW NW

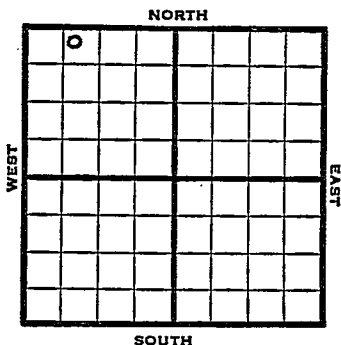

1949

REPORT

8/31

Machine

9/7

Drlg. 745'

9/14

8" @ 800

Drlg-1150'

9/21

Miss 1637'

5" @ 1638'

TD 1677'

9/28

TD 1677'

Miss 1637'

5" @ 1638'

4000 acid

Pump 65 Oil Pot

38<sup>3</sup> Gr.

Comp

**COMPLETED**

Map No. \_\_\_\_\_ Sec. 3 Twp. 24 R. 14E

Well No. 3- Lock

E. Kilby Company

Contractor

NE NW NW

FIRST REPORT  
SECTION PLAT

200 Ft. from N. Line

\_\_\_\_\_ Ft. from S. Line

\_\_\_\_\_ Ft. from E. Line

750 Ft. from W. Line

0			

Woodson County

RECORD

Location \_\_\_\_\_

Cased \_\_\_\_\_ in., \_\_\_\_\_ ft.

Rig up \_\_\_\_\_

Sand \_\_\_\_\_

Drilling and Remarks:

Gas \_\_\_\_\_

Machine \_\_\_\_\_

Oil \_\_\_\_\_

Total Depth \_\_\_\_\_

PRODUCTION

1st 24 hrs. Nat. \_\_\_\_\_

1st 24 hrs. after shot \_\_\_\_\_

Gas \_\_\_\_\_ Cu. Ft.

Dry Hole \_\_\_\_\_

Abandoned \_\_\_\_\_

Date

AUG 31 1949 19

S. J. LEWIS Scout

Map No. \_\_\_\_\_ Sec. 3 Twp. 24 R. 14E

Well No. 3 Lock

E. Kilby Company

COMPLETE Contractor

NE NW NW

SECTION PLAT

200 Ft. from N. Line

\_\_\_\_\_ Ft. from S. Line

\_\_\_\_\_ Ft. from E. Line

750 Ft. from W. Line

0			

Woodson County

Location \_\_\_\_\_

Rig up \_\_\_\_\_

Drilling and Remarks:

*Miss 1607*  
*5" @ 1608.*  
*4000 and*  
*Run 65 oil test*  
*38<sup>2</sup> Ev.*

RECORD

Cased \_\_\_\_\_ in., \_\_\_\_\_ ft.

Sand \_\_\_\_\_

Gas \_\_\_\_\_

Oil \_\_\_\_\_

Total Depth 1677

PRODUCTION

1st 24 hrs. Nat. \_\_\_\_\_

1st 24 hrs. after shot \_\_\_\_\_

Gas \_\_\_\_\_ Cu. Ft.

Dry Hole \_\_\_\_\_

Abandoned \_\_\_\_\_

Date

SEP 28 1949 19

S. J. LEWIS Scout