


Section 36 Township 12 Range 16W

Well No. #6 Austin

Company Stanolind  
Fairport Pool

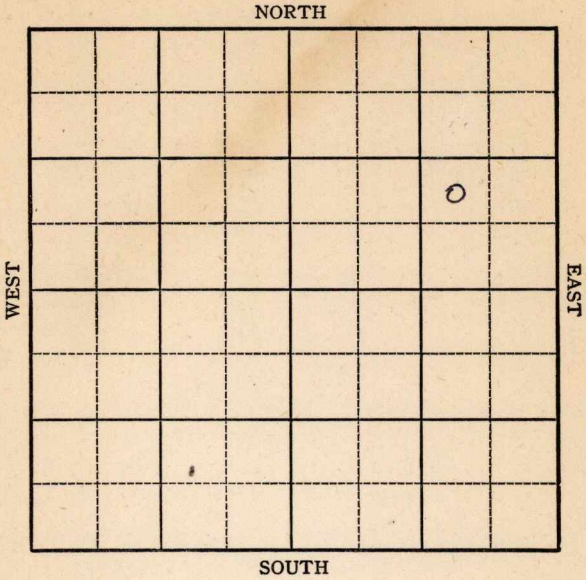

Sec. 36 Twp. 12 R. 16W

Well No. #6 Austin Farm

Stanolind Company


Fairport Pool (Iron Drlg., Contr.)

\_\_\_\_\_ Ft. from N. Line

990' Ft. from S. Line

990' Ft. from E. Line

\_\_\_\_\_ Ft. from W. Line

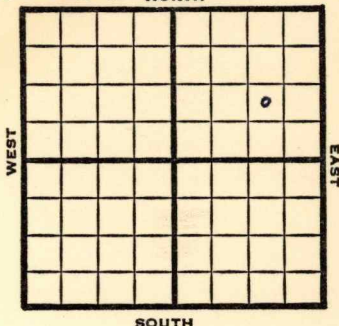

NW SE NE

SOUTH

REPORT

1949 Elev. 1900'

12/7 Anhy 960'

8" @ 970'

12/14 Topeka 2729'

Drlg. 2875'

12/21 Lansing 3018'

Drlg 3095'

12/28 Arb. 3285-91'

TD 3291

Runcsg.

1950

1/11

TD 3291'

8"@ 970'

6" @ 3287'

Est 144 BOPD

Comp

Anhy 960'

Topk 2729-2875'

Heb 2970'

Dodge 2985'

Lan 3018'

Shows of oil stain

3096-3104

3130-37

3170-85'

3199-3208'

Arb. 3285-91 TD

Comp

COMPLETED

Kansas

Map No. \_\_\_\_\_ Sec. 36 Twp. 12 R. 16<sup>W</sup>

Well No. 6 Austin

Stanolind Company

Iron Drlg. Contractor

NW SE NE

FIRST REPORT SECTION PLAT

\_\_\_\_\_ Ft. from N. Line

990 Ft. from S. Line

990 Ft. from E. Line

\_\_\_\_\_ Ft. from W. Line

			o

Ellis County

Location \_\_\_\_\_

Rig up \_\_\_\_\_

Drilling and Remarks:

Anhy 960

8" @ 970

RECORD

Cased \_\_\_\_\_ in., \_\_\_\_\_ ft.

Sand \_\_\_\_\_

Gas \_\_\_\_\_

Oil \_\_\_\_\_

Total Depth \_\_\_\_\_

PRODUCTION

1st 24 hrs. Nat. \_\_\_\_\_

1st 24 hrs. after shot \_\_\_\_\_

Gas \_\_\_\_\_ Cu. Ft.

Dry Hole \_\_\_\_\_

Abandoned \_\_\_\_\_

Date

DEC 7 1949

19

S. J. LEWIS

Scout

Map No. \_\_\_\_\_ Sec. 36 Twp. 12 R. 16W

Well No. 6 Austin

Stanolind

Company

Contractor

NW SE NE

Elev 1900  
SECTION PLAT

\_\_\_\_\_ Ft. from N. Line

990 Ft. from S. Line

990 Ft. from E. Line

\_\_\_\_\_ Ft. from W. Line

			o
COMPLETE			

Ellis County

Location \_\_\_\_\_

Rig up \_\_\_\_\_

Drilling and Remarks:

8" @ 980  
~~5" @ 3291~~  
6" @ 3287  
Est 144 BOPD

RECORD

Cased \_\_\_\_\_ in., \_\_\_\_\_ ft.

Sand \_\_\_\_\_

Gas \_\_\_\_\_

Oil \_\_\_\_\_

Total Depth 3291

PRODUCTION

1st 24 hrs. Nat. \_\_\_\_\_

1st 24 hrs. after shot \_\_\_\_\_

Gas \_\_\_\_\_ Cu. Ft.

Dry Hole \_\_\_\_\_

Abandoned \_\_\_\_\_

Date

JAN 11 1950 19

J. E. TYRA

Scout

ank-960  
Zeph-2729-2875  
Feb 2970  
Dodge 2985  
Len 3018

shawy oil stain

3096-3104  
3130-37  
3178-85  
3199-3208

Arb 3285-91 T.D.

- Scout Cards
- Land Small Map
- Land Wall Map
- Tracings
- France Map
- Pierce Map
- Misc.

*Caith*

JAN 16 1950