

KANSAS

Woodson


Section 4 Township 24 Range 14E

Well No. 4 Heimple

Company C W Darling et al

Misc.

NORTH

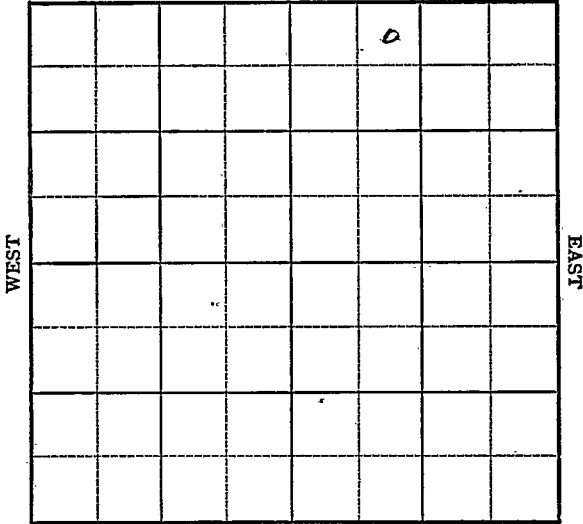

SOUTH

WEST

EAST

KANSAS Woodson

Sec. 4 Twp. 24 R. 14E ✓

Well No. #4 Heimple Farm

C. W. Darling et al Company


Miscellaneous (Charles Barker, Cont.)

330' Ft. from N. Line

_____ Ft. from S. Line

_____ Ft. from E. Line

990' Ft. from W. Line

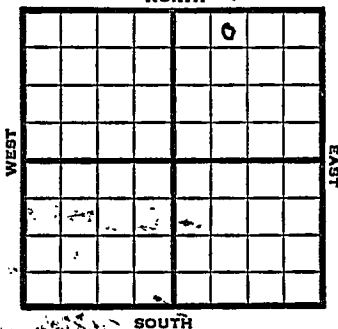

NE NW NE

SOUTH

1949

REPORT

- 5/18 Machine
- 5/25 13" @ 71'
Drlg. 575'
- 6/1 10" @ 840'
Drlg. 970'
- 6/7 Miss 1669-70'
TD 1670'
- 6/15 7"@ 1669'
Miss 1669'
7"@ 1669'
TD 1670'
2000 acid
Pump 300 Oil Pot
38° Gr.
Comp

COMPLETED

Kansas

Map No. _____ Sec. 4 Twp. 24 R. 14EWell No. 4 Heimple_____ C. W. Darling etal. _____ Company_____ Chas. Barker _____ Contractor

NE NW NE

FIRST REPORT
SECTION PLAT_____ 330 Ft. from N. Line

_____ Ft. from S. Line

_____ Ft. from E. Line

_____ 990 Ft. from W. Line

Woodson County

Location _____

Rig up _____

Drilling and Remarks:

Machine _____

RECORD

Cased _____ in., _____ ft.

Sand _____

Gas _____

Oil _____

Total Depth _____

PRODUCTION

1st 24 hrs. Nat. _____

1st 24 hrs. after shot _____

Gas _____ Cu. Ft.

Dry Hole _____

Abandoned _____

Date

MAY 18 1949 19 _____S. J. LEWIS Scout

Woodson County Kansas State

Map No. K17 Sec. 4 Twp. 24 R. 14E

Well No. 4 Heimple

C. W. Darling et al. Company

COMPLETE Contractor

NE NW NE

SECTION PLAT

330 Ft. from N. Line

_____ Ft. from S. Line

_____ Ft. from E. Line

990 Ft. from W. Line

				6	

Miscellaneous

Remarks:

Miss 1669

7" C1669

7" 1670

2000 acid

Pump 300 oil BT

380/30

Date

Scout

JUN 15 1949