

KANSAS



Barton

FORM 51 5M 1-42 PETROL

Section 11 Township 17 Range 11-W

Well No. #8 Hogan "A"

Company Cities Service Oil

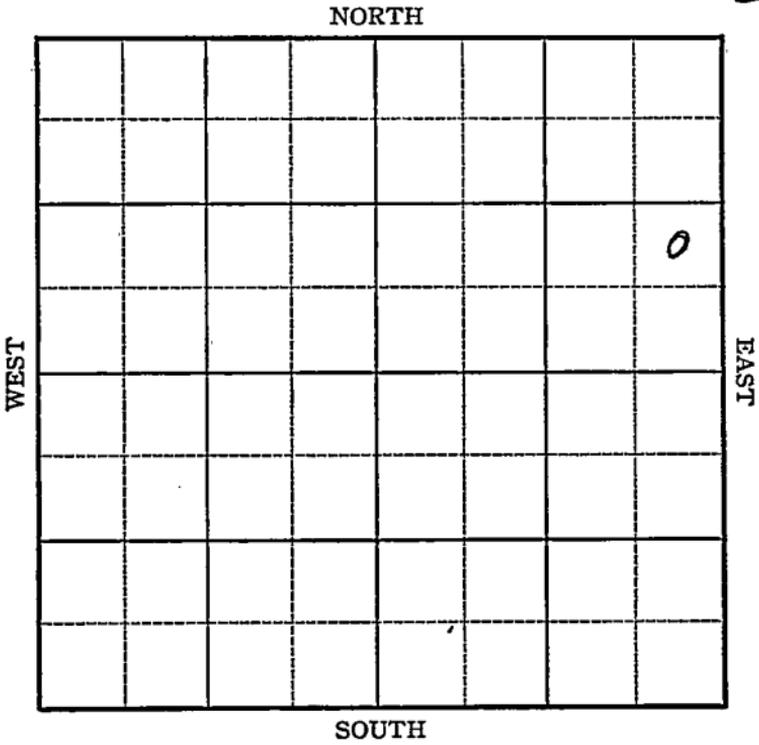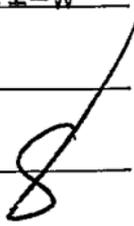

KANSAS

Barton

Sec. 11 Twp. 17 R. 11-W

Well No. #8 Hogan "A" ~ Farm

Cities Service Oil Company

Kraft Prusa


 Ft. from N. Line

990 Ft. from S. Line

330 Ft. from E. Line

 Ft. from W. Line

Elev. 1927

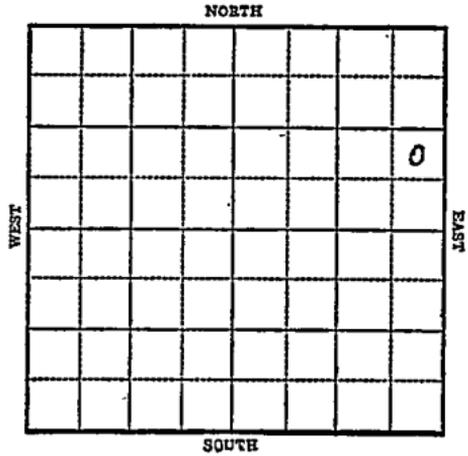

1943

R E P O R T

7/21

Rotary

7/28

8" @ 237'
Drlg. 1980'

8/4

Arb. 3405
T.D. 3435'

ABANDONED

Barton

KANSAS

Map No. 55 Sec. 11 Twp. 17 R. 11W

Well No. 8 Hogan "A"

Cities Service Oil Company

FIRST REPORT Contractor

NE SE NE

SECTION PLAT

_____ Ft. from N. Line

990 Ft. from S. Line

330 Ft. from E. Line

_____ Ft. from W. Line

			0

KRAFT PRUSA POOL

Location _____

Rig up _____

Drilling and Remarks:

Rotary

RECORD

Cased _____ in., _____ ft.

Sand _____

Gas _____

Oil _____

Total Depth _____

PRODUCTION

1st 24 hrs. Nat. _____

1st 24 hrs. after shot _____

Gas _____ Cu. Ft.

Dry Hole _____

Abandoned _____

Date

JUL 21 1943 19

S. J. LEWIS Scout

KANSAS 55 Barton
 Map No. 55 Sec. 11 Twp. 17 R. 11W

Well No. 8 Hogan "A"

Cities Service Oil Company

ABANDONED Contractor

NE SE NE

SECTION PLAT

 Ft. from N. Line

990 Ft. from S. Line

330 Ft. from E. Line

 Ft. from W. Line

			o

KRAFT PRUSA POOL

Location

Rig up

Drilling and Remarks:

Cor 3405

RECORD

Cased in., ft.

Sand

Gas

Oil

Total Depth 3435

PRODUCTION

1st 24 hrs. Nat.

1st 24 hrs. after shot

Gas Cu. Ft.

Dry Hole

Abandoned

Date

AUG 4 1943 19

S. J. LEWIS Scout