

KANSAS


FORM 51 5M 1-42 PETROL

Barton

Section 11 Township 17 Range 11-W

Well No. #7 Hogan "A"

Company Cities Service Oil

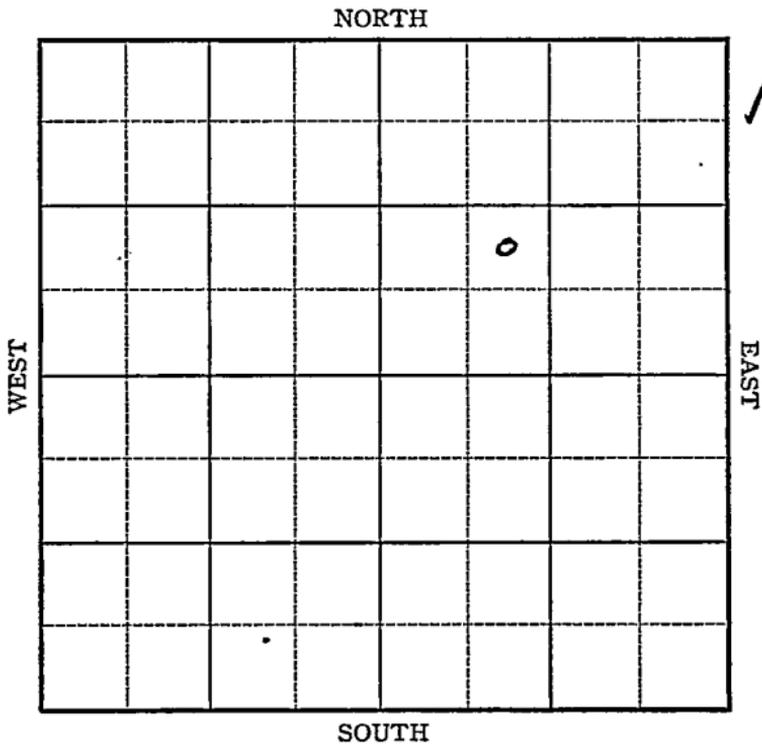

Sec. 11 Twp. 17 R. 11-W

Well No. #7 Hogan "A" Farm

Cities Service Oil Company

Kraft Prusa


 Ft. from N. Line

990 Ft. from S. Line

 Ft. from E. Line

990 Ft. from W. Line

Elev. 1959

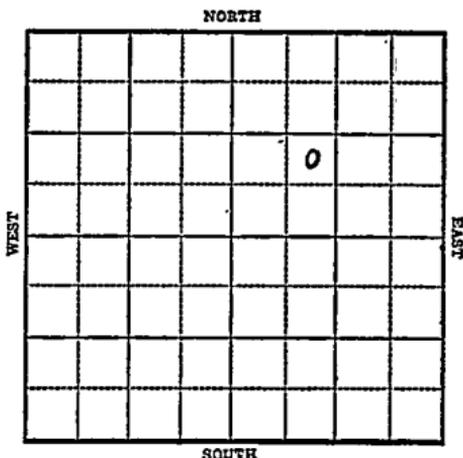

1943

R E P O R T

6/23 8" @ 234'
Waiting on Cement

6/30 Drlg. 2794'

7/7 Arb 3387-90 T.D.
Sat.
5" @ 3389' Rust

7/14 Cong. 3380
5" @ 3389'
Arb. 3387
T.D. 3412'
Pump 186 Pot.
Gravity 42

COMPLETED

Barton

KANSAS
 Map No. 55 Sec. 11 Twp. 17 R. 11W

Well No. 7 Hogan "A"

Cities Service Oil Company

FIRST REPORT Contractor

NE SW NE


SECTION PLAT

_____ Ft. from N. Line

990 Ft. from S. Line

_____ Ft. from E. Line

990 Ft. from W. Line

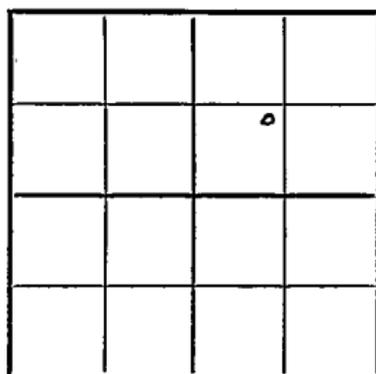

KRAFT PRUSA POOL

Location _____

Rig up _____

Drilling and Remarks:

8"-234'

Waiting on
 cement

RECORD

Cased _____ in., _____ ft.

Sand _____

Gas _____

Oil _____

Total Depth _____

PRODUCTION

1st 24 hrs. Nat. _____

1st 24 hrs. after shot _____

Gas _____ Cu. Ft.

Dry Hole _____

Abandoned _____

Date

JUN 23 1943 19

S. J. LEWIS Scout

KANSAS

Map No. 55 Sec. 11 Twp. 17 R. 11W

Well No. 7 Hogan "A"

Cities Service Oil Company

COMPLETED

Contractor

NE SW NE

SECTION PLAT

_____ Ft. from N. Line

990 Ft. from S. Line

_____ Ft. from E. Line

990 Ft. from W. Line

		0	

KRAFT PRUSA POOL

Location _____

Rig up _____

Drilling and Remarks:

Comp 3380

5-26-3389

Cor 4 3387

Pump 186 P 24

42 e ga

RECORD

Cased _____ in., _____ ft.

Sand _____

Gas _____

Oil _____

Total Depth *8412*

PRODUCTION

1st 24 hrs. Nat. _____

1st 24 hrs. after shot _____

Gas _____ Cu. Ft.

Dry Hole _____

Abandoned _____

Date

JUL 14 1943 19

S. J. LEWIS Scout