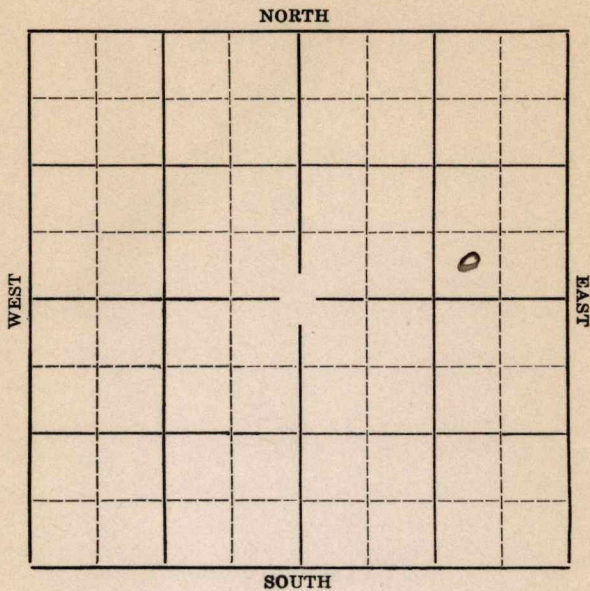


Section 36 Township 12 Range 16-WWell Number #34 L.L. AustinCompany Stanolind

Ellis

Map No. **KANSAS** Sec. **36** Twp. **12** R. **16W**

Well No. **#34 L.L. Austin** Farm


Stanolind Company

Ft. from N. Line

330' Ft. from S. Line

990' Ft. from E. Line

Ft. from W. Line

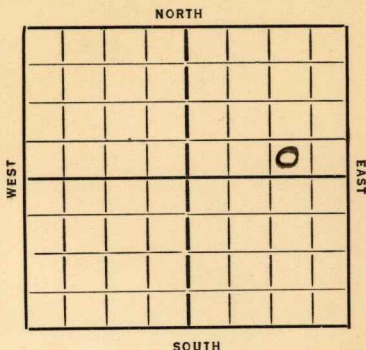

Elev. 1877

Date	REPORT
1936	
8/12	Location
8/20	Rig.
8/27	Rigging up.
9/3	12" @ 815'. Drilling.
9/10	10" @ 931'. Drlg. 1005'.
9/18	Drlg. 1860'.
9/24	Drlg. 2395'.
10/1	Drlg. 2697'.
10/8	8" @ 2707'. Drlg. 2750'.
10/15	6" @ 2750'. Show oil 2885'. TD. 2895'. Under ream 6".
10/22	Oswald 2995' (Corrected) Pay 3017-20'. 300' of oil in 1½ hours.
10/29	Shut down.
11/6	166' of 5" liner 3024. Show oil 3073-76 Drlg. 3080
11/12	T. D. 3125 Swabbing 1½ bbls. per hr.
11/18	Oswald 2995 T. D. 3125 Pot. 232 oil 4% water.
	COMPLETED

KANSAS


Contractor

SECTION PLAT

			0

_____ Ft. from N. Line

330 Ft. from S. Line990 Ft. from E. Line

_____ Ft. from W. Line

FIRST REPORT

Location ✓

Rig up _____

Drilling and Remarks:

RECORD

Cased _____ in., _____ ft.

Sand _____

Gas _____

Oil _____

Total Depth _____

PRODUCTION

1st 24 hrs. Nat. _____

1st 24 hrs. after shot _____

Gas _____ Cu. Ft.

Dry Hole _____

Abandoned _____

Date

AUG 12 1936₁₉

S. J. LEWIS Scout

KANSASMap No. 71 Sec. 36 Twp. 12 R. 16WWell No. 34 L L AustinStanolind Company

Contractor

SECTION PLAT

			0

_____ Ft. from N. Line

330 Ft. from S. Line990 Ft. from E. Line

_____ Ft. from W. Line

COMPLETED

Location _____

Rig up _____

Drilling and Remarks:

Oswald 2995'P & 232. oil4% water**RECORD**

Cased _____ in., _____ ft.

Sand _____

Gas _____

Oil _____

Total Depth 3125**PRODUCTION**

1st 24 hrs. Nat. _____

1st 24 hrs. after shot _____

Gas _____ Cu. Ft.

Dry Hole _____

Abandoned _____

Date

NOV 18 1936 19S. J. LEWIS

Scout