
FORM 51 25M 3-49 PETROL

Barton KANSAS

Section 11 Township 17 Range 11W

Well No. #12 Ehler "A"

Company Eldorado Refg. 15

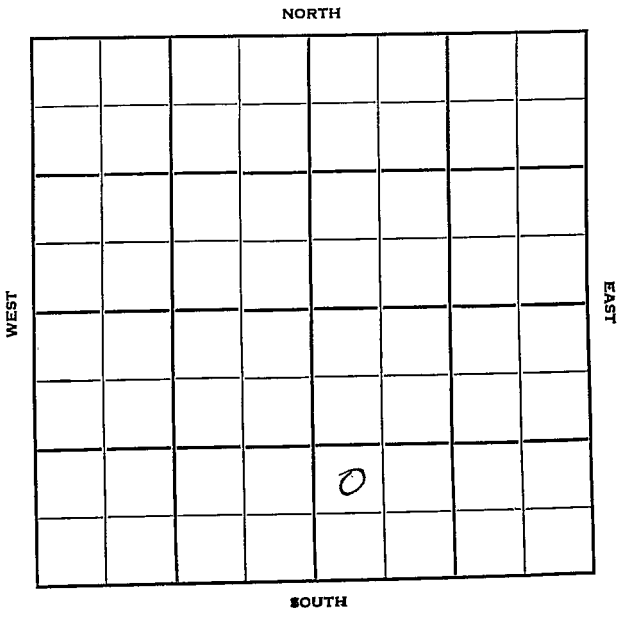

FORM 252-B
10M 9-49 PETROL

Barton KANSAS

Sec. 11 Twp. 17 R. 11W

Well No. #11-Ehler "A" Farm

Eldorado Ref. Company

Contractor

Kraft-Prusa Pool


____ Ft. from N. Line

990' Ft. from S. Line

____ Ft. from E. Line

330' Ft. from W. Line

NW SW SE

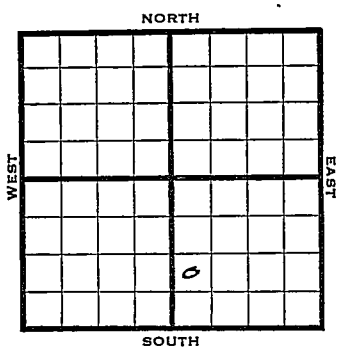

1950	Elev 1908 REPORT
4/26	Spud 4-21-50 8" @ 325' Drlg. 1735'
5/17	TD 3383 8" @ 325 Lans 3067 Cong 3343 Arb 3369 5" @ 3371 3383 TD D&A

ABANDONED

Form 26 200 Bks. 11-49 Petrol

Kansas

Kraft-Prusa Pool

Map No. _____ Sec. 11 Twp. 17 R. 11W


Well No. 11 Ehler "A"

Eldorado Ref. Company

Sterling Drlg. Contractor

NW SW SE

SECTION PLAT

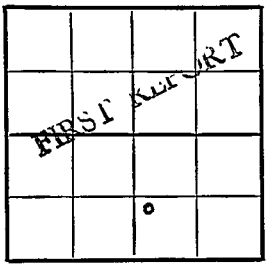

_____ Ft. from N. Line

990 Ft. from S. Line

_____ Ft. from E. Line

330 Ft. from W. Line

Barton County

Location _____

Rig up _____

Drilling and Remarks:

Spud 4-21-50

8" @ 325

drlg. 1735

RECORD

Cased _____ in., _____ ft.

Sand _____

Gas _____

Oil _____

Total Depth _____

PRODUCTION

1st 24 hrs. Nat. _____

1st 24 hrs. after shot _____

Gas _____ Cu. Ft.

Dry Hole _____

Abandoned _____

Date

APR 26 1950 19

J. E. TYRA Scout

Form 26 200 Bks. 11-49 Petrol Kansas Kraft-Prusa Pool

Map No. _____ Sec. 11 Twp. 17 R. 11W

Well No. 11 Ehler "A"


Eldorado Ref. Company

Contractor

NW SW SE

El. 1908

SECTION PLAT

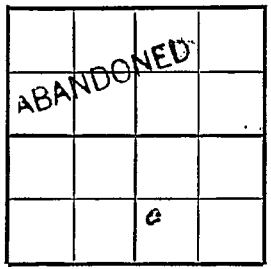

_____ Ft. from N. Line

990 Ft. from S. Line

_____ Ft. from E. Line

330 Ft. from W. Line

Barton

Location _____

Rig up _____

Drilling and Remarks:

8" @ 325'
Lans 3067
Cong 3343
Arb 3369
5" @ 3371
3383 T.D.

RECORD

Cased _____ in., _____ ft.

Sand _____

Gas _____

Oil _____

Total Depth 3383

PRODUCTION

1st 24 hrs. Nat. _____

1st 24 hrs. after shot _____

Gas _____ Cu. Ft.

Dry Hole _____

Abandoned _____

Date D & A

MAY 17 1950

19

J. E. TYRA Scout