


Section 11 Township 17 Range 11-W

Well No. #13 Ehler (A)

Company El Dorado

16

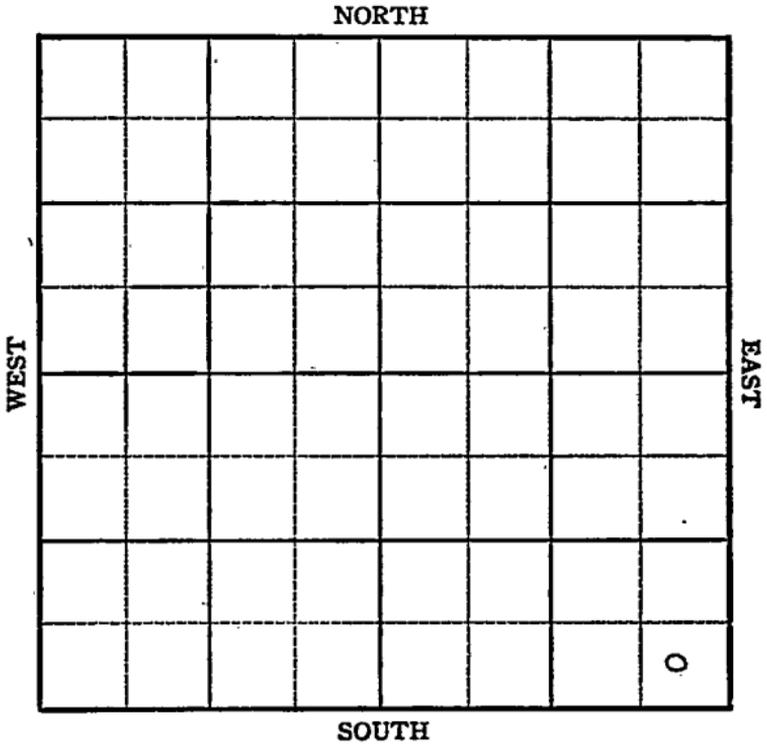

Sec. 11 Twp. 17 R. 11W

Well No. #13 Ehler (A) Farm

El Dorado Company

Contractor

Kraft Prusa


Ft. from N. Line

330' Ft. from S. Line

330' Ft. from E. Line

Ft. from W. Line

SE SE SE

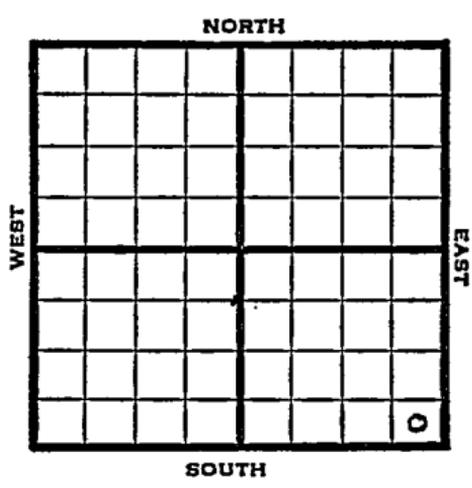

1950. Elev 1895 REPORT

5/17 8" @ 320'
Drlg. 2035'

6/21 TD 3336
 8" @ 320
 Heeb 2925 Br lime 3034
 Lans 3047
 DST 3142-49 opn 30 min, rec 25 mud SSO
 DST 3202-10 opn 1 hr rec 105' SW
 Arb 3317-23
 5" @ 3319
 TD 3336
 FR 300' oil 3 hr
 S/13 boph
 Comp 455 bopd
 Completed
COMPLETED

Map No. _____ Sec. 11 Twp. 17 R. 11W

Well No. 13 Ehler (A)

El Dorado _____ Company

_____ Contractor

SE SE SE

_____ Ft. from N. Line

330 Ft. from S. Line

330 Ft. from E. Line

_____ Ft. from W. Line

SECTION PLAT

FIRST REPORT			
			0

Barton

Location _____

Rig up _____

Drilling and Remarks:

8" @ 320

Drig. 2035

RECORD

Cased _____ in., _____ ft.

Sand _____

Gas _____

Oil _____

Total Depth _____

PRODUCTION

1st 24 hrs. Nat. _____

1st 24 hrs. after shot _____

Gas _____ Cu. Ft.

Dry Hole _____

Abandoned _____

Date

MAY 17 1950

J. E. TYRA Scout

Map No. _____ Sec. 11 Twp. 17 R. 11W

Well No. 13 Ehler "A"

_____ Eldorado Ref. _____ Company

_____ Contractor

SE SE SE


E1. 1895
SECTION PLAT

_____ Ft. from N. Line

330 Ft. from S. Line

330 Ft. from E. Line

_____ Ft. from W. Line

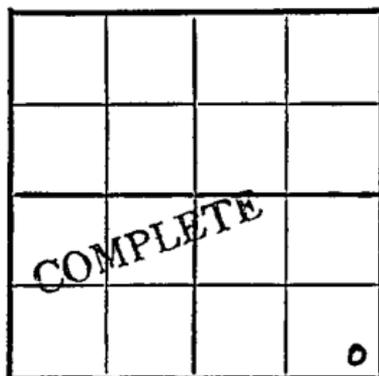

Barton County

Location _____

Rig up _____

Drilling and Remarks:

8" @ 320
Heeb. 2925
Br. lime 3034
Lans. 3047
DST 3142-49
open 30 min.
Reg. 25 mud SSO

RECORD

Cased _____ in., _____ ft.

Sand _____

Gas _____

Oil _____

Total Depth 3336

PRODUCTION

1st 24 hrs. Nat. _____

1st 24 hrs. after shot _____

Gas _____ Cu. Ft.

Dry Hole _____

Abandoned _____

Date

JUN 21 1950 19

J. E. TYRA Scout

