

# KANSAS


FORM 51 5M 1-42 PETROL

Barton

Section 12 Township 17 Range 11-W

Well No. #1 Ehler Estate

Company Winkler-Koch

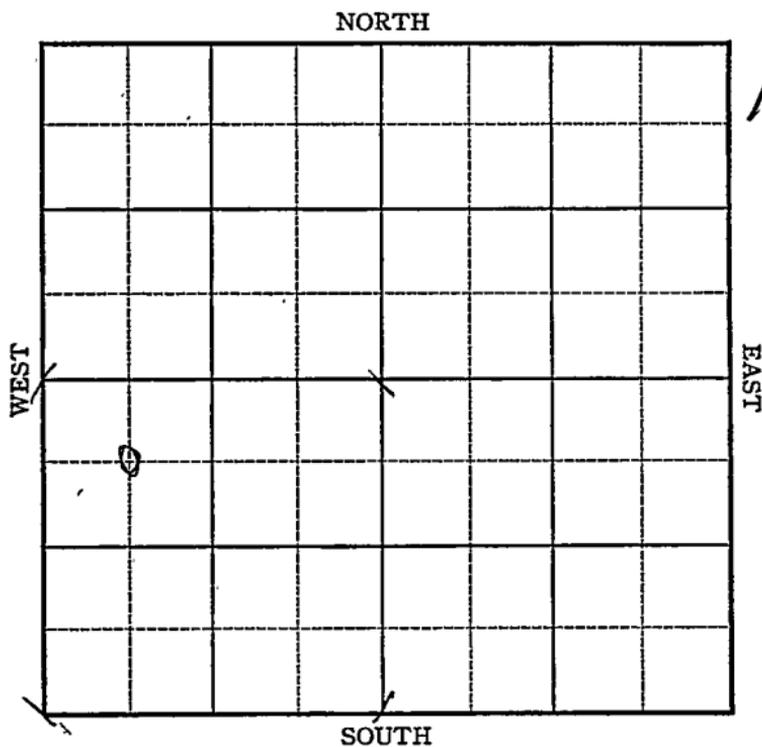

Sec. 12 Twp. 17 R. 11-W

Well No. #1 Ehler Estate Farm

Winkler-Koch Company

Kraft Prusa


660 Ft. from N. Line

\_\_\_\_\_ Ft. from S. Line

\_\_\_\_\_ Ft. from E. Line

660 Ft. from W. Line

*Elev. 1922*

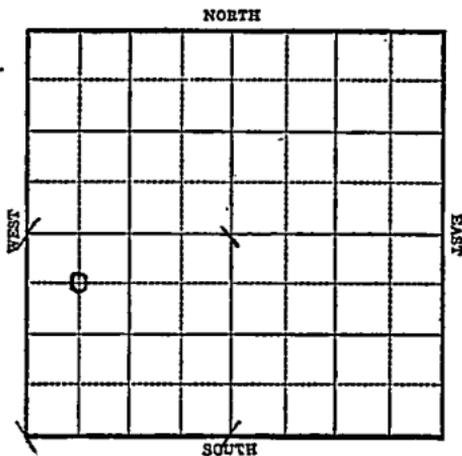

1943

R E P O R T

- 7/14 Derrick
- 7/21 Surface hoel
- 7/28 8"  $\omega$  280'  
Drlg. 2165'
- 8/4 Lans 3085  
Drlg. 3300'
- 8/11 Cong 3365'  
T.D. 3396'

**ABANDONED**

Map No. **33** Sec. **12** Twp. **17** R. **11W**

Well No. **1 Ehler Estate**

**Winkler-Koch** Company

**FIRST REPORT** Contractor

**C NW SW**


**SECTION PLAT**

**660** Ft. from N. Line

\_\_\_\_\_ Ft. from S. Line

\_\_\_\_\_ Ft. from E. Line

**660** Ft. from W. Line

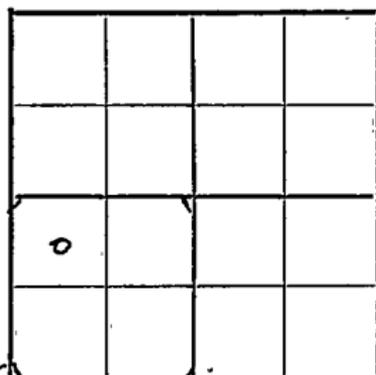

**KRAFT PRUSA POOL**

Location \_\_\_\_\_

Rig up \_\_\_\_\_

Drilling and Remarks:

**Derrick**

**RECORD**

Cased \_\_\_\_\_ in., \_\_\_\_\_ ft.

Sand \_\_\_\_\_

Gas \_\_\_\_\_

Oil \_\_\_\_\_

Total Depth \_\_\_\_\_

**PRODUCTION**

1st 24 hrs. Nat. \_\_\_\_\_

1st 24 hrs. after shot \_\_\_\_\_

Gas \_\_\_\_\_ Cu. Ft.

Dry Hole \_\_\_\_\_

Abandoned \_\_\_\_\_

Date

**JUL 14 1943**

**S. J. LEWIS** Scout

Barton

Map No. **KANSAS** Sec. 12 Twp. 17 R. 11W

Well No. 1 Ehler Estate

Winkler-Koch Company

ABANDONED Contractor

C NW SW

SECTION PLAT

660 Ft. from N. Line

\_\_\_\_\_ Ft. from S. Line

\_\_\_\_\_ Ft. from E. Line

660 Ft. from W. Line


KRAFT PRUSA POOL

Location \_\_\_\_\_

Rig up \_\_\_\_\_

Drilling and Remarks:

*Cong 3365*

RECORD

Cased \_\_\_\_\_ in., \_\_\_\_\_ ft.

Sand \_\_\_\_\_

Gas \_\_\_\_\_

Oil \_\_\_\_\_

Total Depth 3996

PRODUCTION

1st 24 hrs. Nat. \_\_\_\_\_

1st 24 hrs. after shot \_\_\_\_\_

Gas \_\_\_\_\_ Cu. Ft.

Dry Hole \_\_\_\_\_

Abandoned \_\_\_\_\_

Date

AUG 1 1 1943

19

S. J. LEWIS Scout