

✓

Sec. 11 Twp. 17 R. 11W

Well No. #12 Ehler "A" Farm

Eldorado Refg. Company

Kraft-Prusa Pool Contractor

_____ Ft. from N. Line

330'


_____ Ft. from S. Line

_____ Ft. from E. Line

990'

_____ Ft. from W. Line

SE SW SE

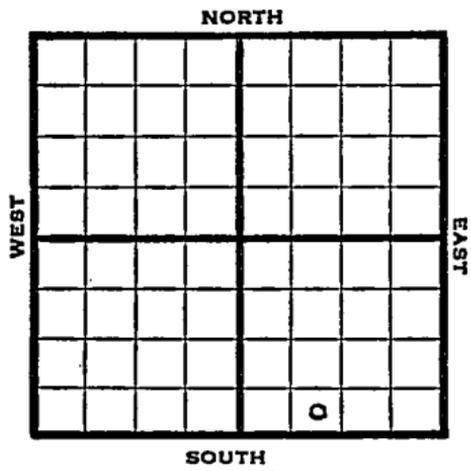

1950 Elev. 1897' REPORT

5/3 Rig up

6/7 8" @ 318'
 Heeb 2929'
 Lans. 3043'
 Arb 3339'
 5" @ 3340'
 421 BOPD
 TD 3347'

COMPLETED

Map No. _____ Sec. 11 Twp. 17 R. 11W

Well No. 12 Ehler "A"

_____ Eldorado Ref. _____ Company

_____ Contractor

SE SW SE

E 1.1897

SECTION PLAT

_____ Ft. from N. Line

330 Ft. from S. Line

_____ Ft. from E. Line

990 Ft. from W. Line

			o

FIRST REPORT

Barton County

Location _____

Rig up X

Drilling and Remarks:

RECORD

Cased _____ in., _____ ft.

Sand _____

Gas _____

Oil _____

Total Depth _____

PRODUCTION

1st 24 hrs. Nat. _____

1st 24 hrs. after shot _____

Gas _____ Cu. Ft.

Dry Hole _____

Abandoned _____

Date

MAY 3 1950 19

J. E. TYRA

Scout

Kansas

Map No. _____ Sec. 11 Twp. 17 R. 11W

Well No. 12 Ehler "A"

Eldorado Ref. Company

SE SW SE Contractor El. 1897

SECTION PLAT

_____ Ft. from N. Line

330 Ft. from S. Line

_____ Ft. from E. Line

990 Ft. from W. Line

		COMPLETE	
			o

Barton

RECORD

Location _____

Cased _____ in., _____ ft.

Rig up _____

Sand _____

Drilling and Remarks:

Gas _____

Oil _____

Total Depth 3347

*8" @ 318
 Herb 2929
 Lane 3043
 Arb 3339
 5" @ 3340
 421 BOPD.*

PRODUCTION

1st 24 hrs. Nat. _____

1st 24 hrs. after shot _____

Gas _____ Cu. Ft.

Dry Hole _____

Abandoned _____

Date

JUN 7 1950 19

J. E. TYRA Scout