

Barton


FORM 51

KANSAS

Section 11 Township 17 Range 11W

Well No. #13 Hogan "A"

Company Cities Service

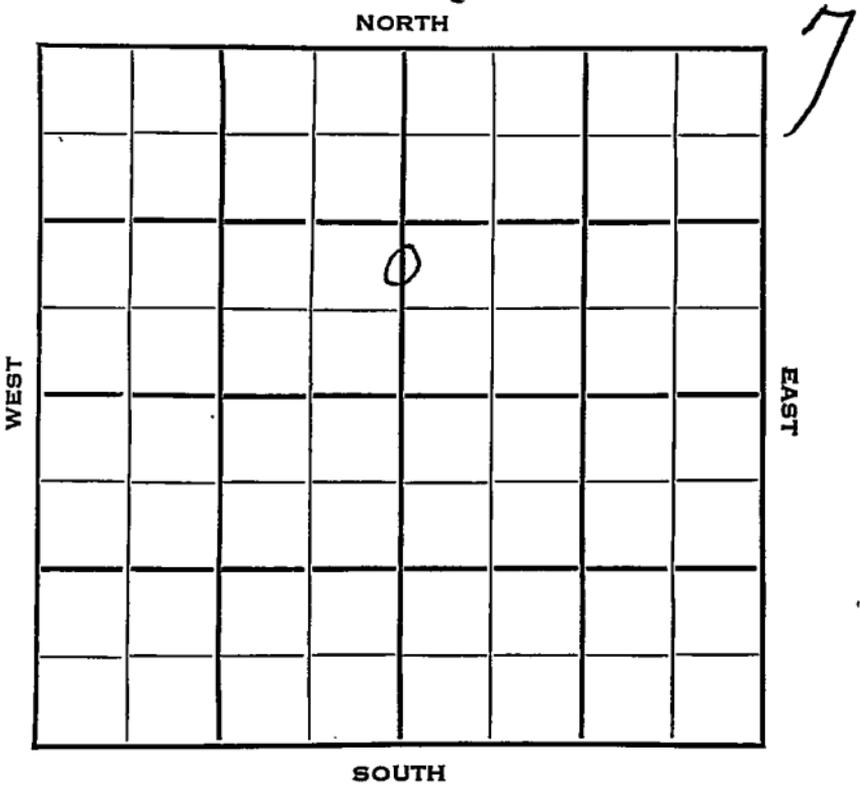

Barton

FORM 252-B

KANSAS ✓

Sec. 11 Twp. 17 R. 11WWell No. #13 Hogan "A" FarmCities Service Company


"

Kraft-Prusa Pool Contractor1650 Ft. from N. Line

Ft. from S. Line

2640 Ft. from E. Line

Ft. from W. Line

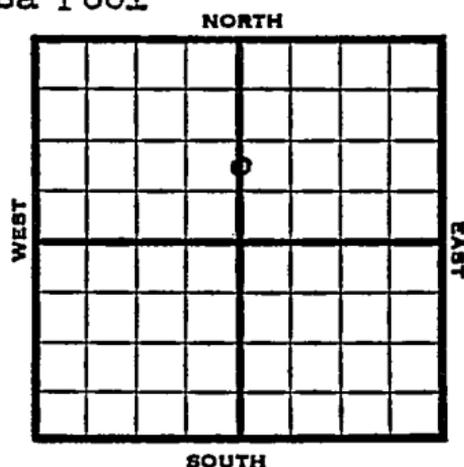C N $\frac{1}{2}$  S $\frac{1}{2}$  N $\frac{1}{2}$ 

1953 Elev. 1926' REPORT

8/12 Location

8/19 8" @ 453  
Drlg. 1995'8/26 KC 3099' Arb. 3354' RTD 3355  
5" @ 33559/2 CO 3355  
DD 3356  
TD  
FU 1345' oil 1 $\frac{1}{2}$  hrs.

9/9 N.R.

9/16 NR

10/7 NR

10/14 Spud 8-15-53 Oil well TD 3356  
8" @ 453 KC 3099 Arb. 3354  
TD 3355 5" @ 3355 CO to 3355  
DD 3356' FU 1345' oil 1 $\frac{1}{2}$  hr.  
P/153 BOPD 4% wtr.  
Comp. 44 BOPD 44 BW**COMPLETED**




County Barton State Kansas

Sec. 11 (Blk. Twp.) 17 (Sur. Rge.) 11W Map No.

Operator Cities Service

Well No. 13 Farm Hogan "A"

Elev. 1926 Location C N $\frac{1}{2}$ S $\frac{1}{2}$ N $\frac{1}{2}$

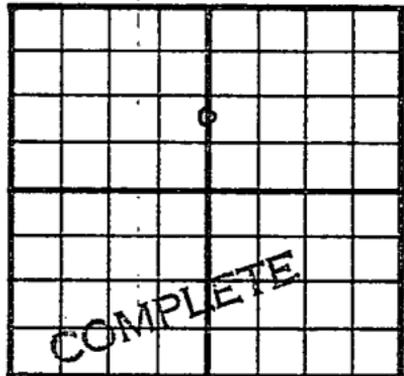

1650 Ft. From N Line Sec.

2640 Ft. From E Line Quarter

Ist. Report

Completion OCT 14 1950

Remarks Kraft-Prusa Pool

Spudding Date 8-15-53

Drlg. Data Oil well TD 3356

8" @ 453 KC 3099 Arb. 3354 TD 3355

5" @ 3355 CO to 3355 DD 3356

FU 1345' oil 1 $\frac{1}{2}$  hr. P/ 153 bopd 4% wtr.

Comp. 44 bopd 44 bw