

KANSAS

Barton


FORM 51 5M 4-41 PETROL

Section 12 Township 17 Range 11-W

Well No. #1 Ehler

Company Transwestern

NORTH Kraft pool

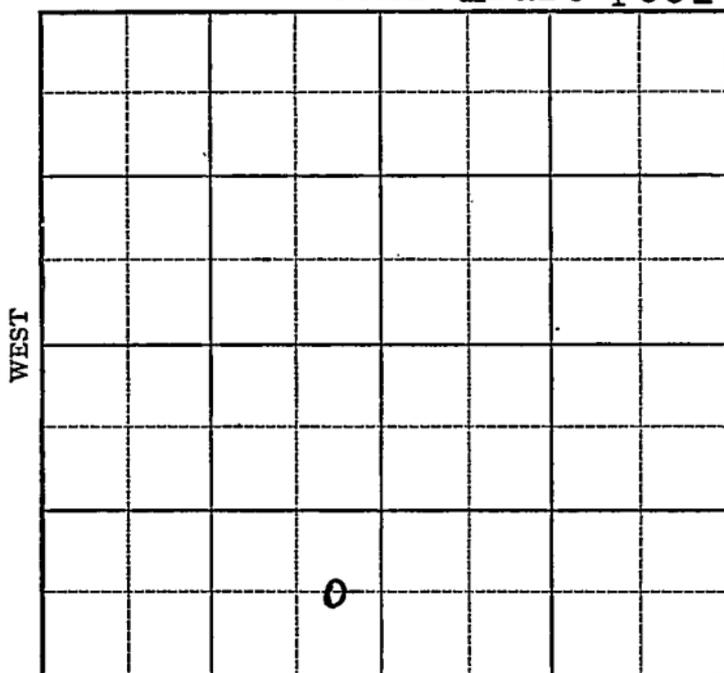

14

SOUTH

Map No. 55 Sec. 12 Twp. 17 R. 11W

Well No. 1 Ehler

Transwestern Company

Contractor

FIRST REPORT

SECTION PLAT


C E L S E SW

 Ft. from N. Line

660 Ft. from S. Line

330 Ft. from E. Line

 Ft. from W. Line

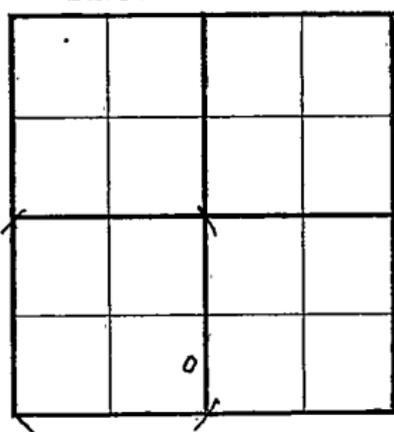

KRAFT POOL

Location

Rig up

Drilling and Remarks:

8" - 261

Drlg. 869

RECORD.

Cased in., ft.

Sand

Gas

Oil

Total Depth

PRODUCTION

1st 24 hrs. - Nat.

1st 24 hrs. after shot

Gas Cu. Ft.

Dry Hole

Abandoned

Date

MAY 27 1941 19

S. J. LEWIS Scout

Map No. 55 Sec. 12 Twp. 17 R. 11WWell No. 1 Ehler

Transwestern

Company

ABANDONED

Contractor

C E L S E S W

_____ Ft. from N. Line

660 Ft. from S. Line330 Ft. from E. Line

_____ Ft. from W. Line

SECTION PLAT

KRAFT POOL

Location _____

Rig up _____

Drilling and Remarks:

Cr 43366
5' @ 3366.
Water

RECORD

Cased _____ in., _____ ft.

Sand _____

Gas _____

Oil _____

Total Depth 3374 1/2

PRODUCTION

1st 24 hrs. Nat. _____

1st 24 hrs. after shot _____

Gas _____ Cu. Ft.

Dry Hole _____

Abandoned _____

Date

JUN 11 1941

19

S. J. LEWIS Scout