FORM 51 10M 2-49 PETROL


KANSAS Barton

Section 12 Township 17 Range 11-W

Well No. #2 Andrea

Company Sunray

Kraft-Prusa Pool

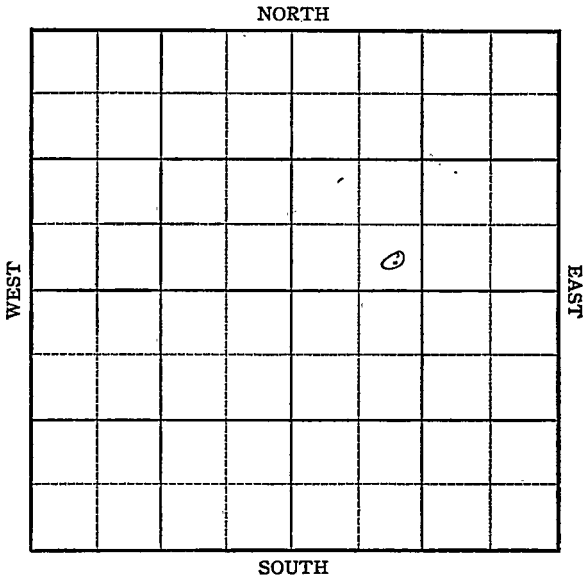

7

FORM 252-B
10M 9-49 PETROL

Barton KANSAS

Sec. 12 Twp. 17 R. 11W

Well No. #2 Andrea Farm

Sunray Company

Kraft-Prusa Pool

Contractor


Ft. from N. Line

330' Ft. from S. Line

Ft. from E. Line

990' Ft. from W. Line

SE SW NE

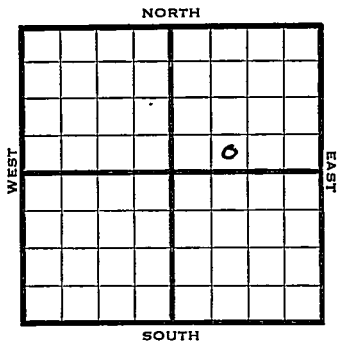

1949	REPORT
11/9	Location
11/16	"
11/23	"
11/29	"
12/8	8"@ 270' Drlg 1200'
12/14	Lansing 3058' Drlg. 3150'
12/21	TD 3345' 5"@ 3343'
12/28	TD 3351' 500 acid Swb 35 bbls oil PH
1950 1/4	TD 3351' 8"@ 270 Heeb 2941' Lans 3058' Cong 3336' Arb. 3341' 5"@ 3343' 1800' oil in 4 hrs. 500 acid Swab 35 Oil ph Comp 391 Oil trace of wtr. Comp

COMPLETED

Form 26 200 Bks. 6-49 Petrol

Kansas

Kraft-Prusa Pool

Map No. ____ Sec. 12 Twp. 17 R. 11W

Well No. 2 Andrea


Sunray Company

Contractor

SE SW NE

FIRST REPORT

SECTION PLAT

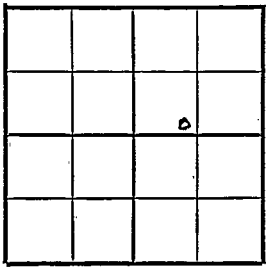

____ Ft. from N. Line

330 Ft. from S. Line

____ Ft. from E. Line

990 Ft. from W. Line

Barton County

Location X

Rig up

Drilling and Remarks:

RECORD

Cased ____ in., ____ ft.

Sand

Gas

Oil

Total Depth

PRODUCTION

1st 24 hrs. Nat.

1st 24 hrs. after shot

Gas ____ Cu. Ft.

Dry Hole

Abandoned

Date

NOV 9 1949 19

S. J. LEWIS Scout

Form 26 200 Bks. 6-49 Petrol

Kansas

Kraft-Prusa

Map No. ____ Sec. 12 Twp. 17 R. 11W


Well No. 2 Andrea

Sunray Company

Contractor

SE SW NE

SECTION PLAT

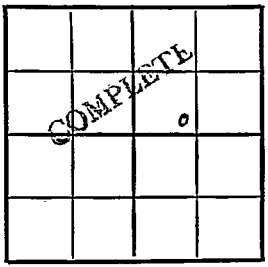

____ Ft. from N. Line

330 Ft. from S. Line

____ Ft. from E. Line

990 Ft. from W. Line

Barton County

Location

Rig up

Drilling and Remarks:

8"@ 270
Heb. 2941
Lans. 3058
Cong. 3336
Arb. 3341
5"@ 3343
1800' oil in 4 hrs.
500 acid
swab 35 oil ph.
Comp. 391 oil
Date trace of water

JAN 4 1950

RECORD

Cased ____ in., ____ ft.

Sand

Gas

Oil

Total Depth 3351

PRODUCTION

1st 24 hrs. Nat.

1st 24 hrs. after shot

Gas ____ Cu. Ft.

Dry Hole

Abandoned

19 J. E. Lyon Scout