

KANSAS

Barton

Form 51-5M-7-40-Palace

Section 12 Township 17 Range 11-W

Well No. #3 Fee

Company Transwestern et al

NORTH

Kraft Pool

WEST

EAST

SOUTH

15

6

Sec. 12 Twp. 17 R. 11-W

Well No. #3 Fee Farm

Transwestern et al Company

(Kraft)


_____ Ft. from N. Line

660 Ft. from S. Line

_____ Ft. from E. Line

99.0 Ft. from W. Line

Elev. 1883

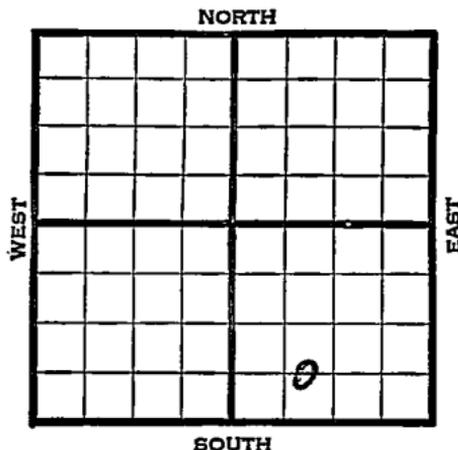

REPORT	
1940	
11/26	Location
12/5-	"
12/12	10" - 274' Anhy 615'
	Drlg. 1440'
12/19	Drlg. 2945'
12/26	Lans. 2985' 5" - 328 4'
	Arb. 328 4-88' T.D. RUST.
1941	
1/2	" " "
1/8	Arb. 328.2'
	5" - 328 2'
	T.D. 330 6 1/2'
	Depthograph potential 3071 bbls.
	Maximum 3000 bbls.
	43. Gravity
COMPLETED	

Map No. 55 Sec. 12 Twp. 17 R. 11W

Well No. 3 Fee

Transwestern etal Company

Contractor

FIRST REPORT
C E L SW SE

SECTION PLAT

 Ft. from N. Line

660 Ft. from S. Line

 Ft. from E. Line

990 Ft. from W. Line

		o	

KRAFT POOL

Location X

Rig up

Drilling and Remarks:

RECORD

Cased in., ft.

Sand

Gas

Oil

Total Depth

PRODUCTION

1st 24 hrs. Nat.

1st 24 hrs. after shot

Gas Cu. Ft.

Dry Hole

Abandoned

Date

NOV 26 1940 19

S. J. LEWIS Scout

Map No. 55 Sec. 12 Twp. 17 R. 11WWell No. 3 Fee

Transwestern etal Company

Contractor

COMPLETED

C E L SW SE

_____ Ft. from N. Line

660 Ft. from S. Line

_____ Ft. from E. Line

990 Ft. from W. Line

KRAFT POOL

SECTION PLAT

Location _____

Rig up _____

Drilling and Remarks:

*Cor & 3282.**5" C 3282.**Depth to P & 3071*
*May 3000**43° Se.***RECORD**

Cased _____ in., _____ ft.

Sand _____

Gas _____

Oil _____

Total Depth 3206 1/2**PRODUCTION**

1st 24 hrs. Nat. _____

1st 24 hrs. after shot _____

Gas _____ Cu. Ft.

Dry Hole _____

Abandoned _____

Date

JAN 8 1941 19

S. J. LEWIS Scout