


Section 36 Township 12 Range 16-W

Well Number #6-Weiland

Company Beardmore et al

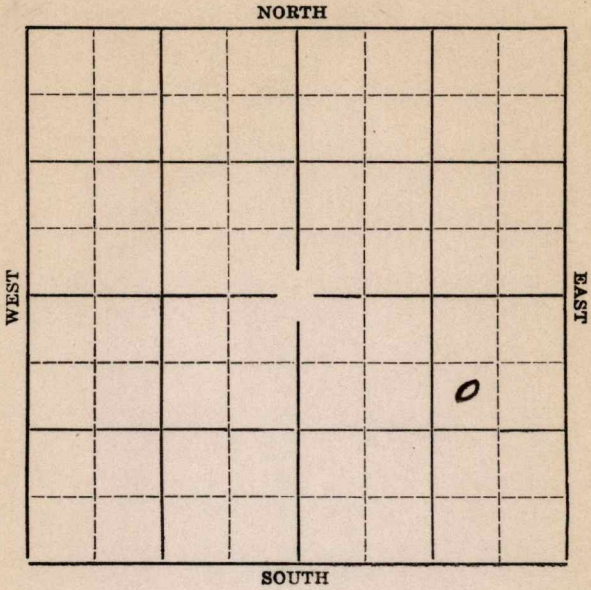

KANSAS

Ellis

Sec. 36 Twp. 12 R. 16W

Well No. #6 Weiland Farm


Beardmore et al Company

990' Ft. from N. Line

_____ Ft. from S. Line

990' Ft. from E. Line

_____ Ft. from W. Line

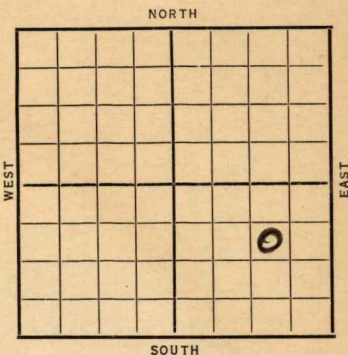

Elev. 1877

Date	REPORT
8/26	Rigging up
9/3--	
9/10	Shut down.
9/18---	9/24-- 10/1-- 10/8-- 10/15--
10/22--	10/29-- 11/6-- 11/12---
11/19---	
11/27	660 fishing.
12/3	10" @ 983'. Drlg. 1760'.
12/10	Drlg. 2450'.
12/17	Gas 2410-20'. 2525 U R 8".
12/24	Drlg. 2578'.
12/29	Drlg. 2850'.
1937	
1/7	Drlg. 3175'.
1/14	Fishing 3175'.
1/21	Shut down 3175'.
1/28	Fishing 3175'.
2/4	Shut down 3175'
2/11	" " "
2/19	" " "
2/26	" " "

OVER

1937
 3/4 Shut Down 3175'
 3/11 " " "
 3/18 " " "
 3/25 " " "
 4/2 " " "
 4/8 " " "
 4/16 " " "
 4/23 " " "
 4/30 " " "
 5/7 " " "
 5/14 " " "
 5/21 Oswald 3009'. 6" @ 3100'.
 T.D. 3185'. C.O.
 5/28 Drlg. 3290'.
 6/4 6" @ 3215'. T.D. 3357'.
 H.F.W. Will P.B. to 3275'.
 6/11 " " " " "
 6/19 " " " " "
 6/25 " " " " "
 6/30 6" @ 3215'.
 Oswald 3009'.
 T.D. 3357' H.F.W.
 P.B. 3250'.
 Pot. 25 bbls.

COMPLETED

KANSAS

Map No. 71 Sec. 36 Twp. 12 R. 16W

Well No. 6 Heiland

Beardmore & Dal. Company

Contractor

SECTION PLAT

990 Ft. from N. Line

_____ Ft. from S. Line

990 Ft. from E. Line

_____ Ft. from W. Line

			0

FIRST REPORT

Location _____

Rig up _____

Drilling and Remarks:

Rigging up.

RECORD

Cased _____ in., _____ ft.

Sand _____

Gas _____

Oil _____

Total Depth _____

PRODUCTION

1st 24 hrs. Nat. _____

1st 24 hrs. after shot _____

Gas _____ Cu. Ft.

Dry Hole _____

Abandoned _____

Date

AUG 26 1936

S. J. LEWIS

Scout

Ellis KANSAS

Map No. _____ Sec. 26 Twp. 12 R. 16^w

Well No. 6-Weiland

Beardmore et al Company

Contractor

COMPLETED

SECTION PLAT

990 Ft. from N. Line

_____ Ft. from S. Line

990 Ft. from E. Line

_____ Ft. from W. Line

			0

Location _____

Rig up _____

Drilling and Remarks:

P.B. 3250

RECORD

Cased 6 in., 3215 ft.

Sand Oswald-3009

Gas _____

Oil _____

Total Depth 3357

PRODUCTION

H.F.W.

1st 24 hrs. Nat. _____

1st 24 hrs. after shot _____

Gas _____ Cu. Ft.

Dry Hole _____

Abandoned _____

Post 25

Date

JUN 30 1937 19

H. D. Hatfield

Scout