KANSAS


Ellis

Form 51—5M—11-31—Palace

Map No. ____ Sec. 36 Twp. 12 R. 16W

Well No. 4 Weiland Farm

Beadmore, Palmer & Gypsy Company

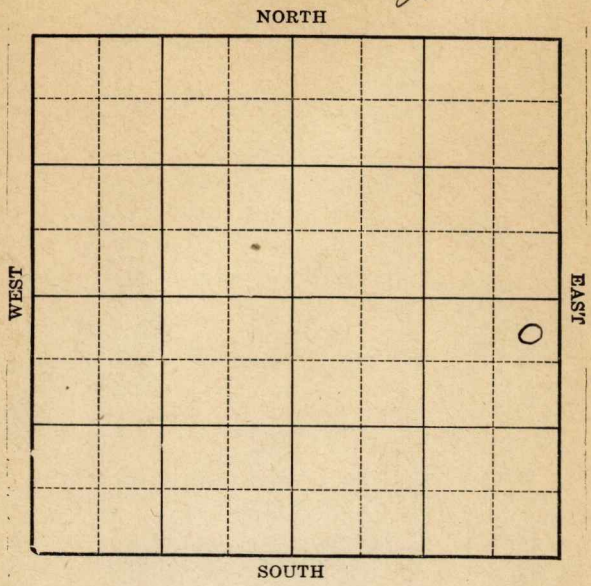

Location ____

Drilling Remarks

Rig Up ____

Drilling Remarks

RECORD

Cased ____ in. ____ ft.

Sand ____

Gas ____

Oil ____

Total Depth ____

PRODUCTION

1st 24 hrs. Nat. ____

1st 24 hrs. after shot ____

Gas ____ cu. ft. ____

Dry Hole ____

Abandoned ____

Ellis

Form 252-A
5M 4-32 MPC

Map No. KANSAS Sec. 36 Twp 12 R. 16 W

Well No. 4 Weiland Farm


Beardmore, Palmer & Hyppey Company

330 Ft. from N. Line

Ft. from S. Line

330 Ft. from E. Line

Ft. from W. Line

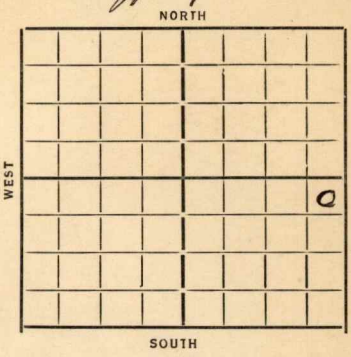

Date 1934	REPORT
3/7	Bldg Rig
3/15	Rig
3/22	—
3/29	Drlg 590 15" 330 12" 555
4/5	" 1100 10" at 945
4/12	Drlg 1175
4/19	Drlg 1350
4/26	" 2100
5/3	" 2130
5/10	Show gas 2460 - 70 Drlg 2510
5/18	Drlg 2754 S.O. 2730
5/25	" 3070 6" 3020
	S.O. 3030 - 35
5/31	Top Oswald 3105 TD
	Swabbed 20 Bbls per hr.
6/6	Oswald 3105 TD 3105
	25 Bbls per hr.

COMPLETED

Form 26—1M Bks. 9-28

Map No. 71 Sec. 36 Twp. 12 R. 16W

Well No. 4—Weiland

Beadmore, Palmer & Gypsy Company

Contractor

FIRST REPORTS


330 Ft. from N. Line

Ft. from S. Line

330 Ft. from E. Line

Ft. from W. Line

SECTION PLAT

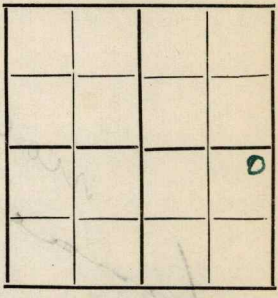

Location

Rig up

Drilling and Remarks:

Bldg Rig

RECORD

Cased in., ft.

Sand

Gas

Oil

Total Depth

PRODUCTION

1st 24 hrs. Nat.

1st 24 hrs. after shot

Gas Cu. Ft.

Dry Hole

Abandoned

Date

3-7-34 192 O. Mannschreck Scout

Form 26—1M Blks.—2-29

Map No. 71 Sec. 36 Twp. 12 R. 16W

Well No. 4 – Weiland

Beadmore etal Company

Contractor

COMPLETED


330 Ft. from N. Line

Ft. from S. Line

330 Ft. from E. Line

Ft. from W. Line

SECTION PLAT

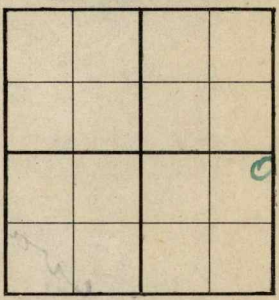

Location

Rig up

Drilling and Remarks:

25 bbls per hr

RECORD

Cased in., ft.

Sand Cored 3105

Gas

Oil

Total Depth 3105

PRODUCTION

1st 24 hrs. Nat.

1st 24 hrs. after shot

Gas Cu. Ft.

Dry Hole

Abandoned

Date

6-6-37 19

ORVAL MANNSCHRECK Scout