

Sec. 12 Twp. 17 R. 11W

Well No. #2-Ehler "B" Farm

Eldorado Ref. Et al Company

Kraft-Prusa Pool


_____ Ft. from N. Line

330' Ft. from S. Line

_____ Ft. from E. Line

990' Ft. from W. Line

SE SW SW

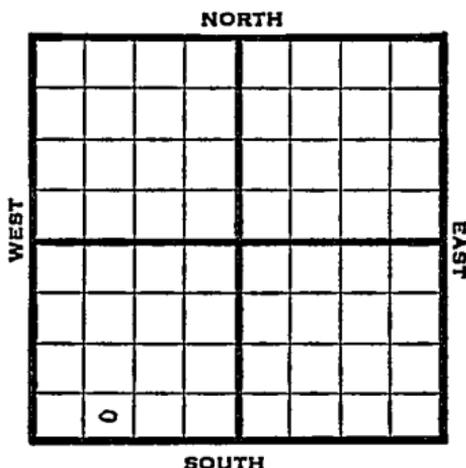

1948

Eli 1901'

REPORT

6/16

Location

6/23

"

6/29

"

7/8

"

7/14

8" @ 307'

WOC

7/21

Drlg 3092'

7/28

Lansing 3056'

Arb. 3348'-53'

TD 3353'

5" @ 3350'

8/4

TD 3356'

Swab 63 bbls. oil 12 hrs.

8/11

"

"

8/18

"

" "

8/25

"

"

9/1

Arb. 3348'

5" @ 3350'

TD 3356'

Pump 180 oil Pot

42° Gr.

Comp

COMPLETED

Map No. _____ Sec. 12 Twp. 17 R. 11W

Well No. 2 Ehler "B"

Eldorado Ref. etal. Company

FIRST REPORT

Contractor

SE SW SW

SECTION PLAT

_____ Ft. from N. Line

330 Ft. from S. Line

_____ Ft. from E. Line

990 Ft. from W. Line

Barton County

Location X

Rig up _____

Drilling and Remarks: _____

RECORD

Cased _____ in _____ ft.

Sand _____

Gas _____

Oil _____

Total Depth _____

PRODUCTION

1st 24 hrs. Nat. _____

1st 24 hrs. after shot _____

Gas _____ Cu. Ft.

Dry Hole _____

Abandoned _____

Date

JUN 16 1948 19

S. J. LEWIS Scout

