FORM 51 25M 3-49 PETROL


KANSAS

Barton

Section 12 Township 17 Range 11-W

Well No. #6 Ehler "B"

Company Elreco

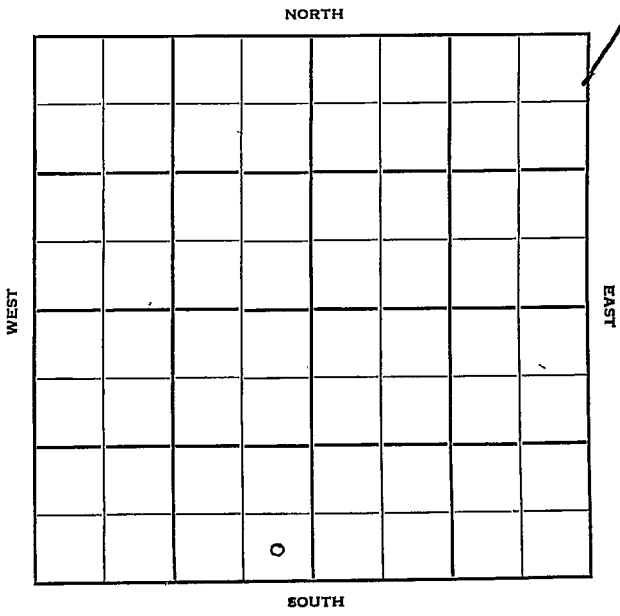

FORM 252-B
10M 9-49 PETROL

Barton KANSAS

Sec. 12 Twp. 17 R. 11W

Well No. #6 Ehler "B" Farm

Elreco Company

Sterling Drlg. Contractor

Kraft-Prusa Pool


Ft. from N. Line

330' Ft. from S. Line

330' Ft. from E. Line

Ft. from W. Line

SE SE SW

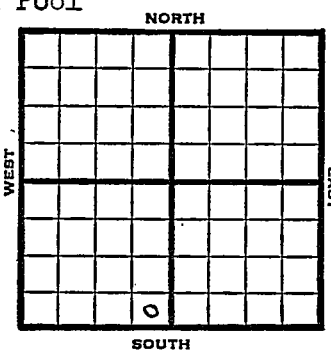

1950	Elev 1890 REPORT
6/28	Spud 6-22-50 8"@ 318' Drlg. 2133'
8/23	TD 3578 8" @ 318 Lans 3034 DST 3105-12 opn ½ hr rec 850' gas 55' oil Cong 3316 Arb 3365 Granite 3536-78 TD 5" @ 3400 CO to 3378 12/3106-09 500 A 5-10 goph 2000 A Comp 40 bopd 29% wtr Completed

COMPLETED

Form 26 200 Bks. 11-49 Petrol

Kansas

Kraft-Prusa Poo

Map No. _____ Sec. 12 Twp. 17 R. 11W

Well No. 6 Ehler "B"

Elreco Company

Sterling Drlg. Contractor

SE SE NW

_____ Ft. from N. Line

330 Ft. from S. Line

330 Ft. from E. Line

_____ Ft. from W. Line

SECTION PLAT



Barton County

Location _____

Rig up _____

Drilling and Remarks:

Spud 6-22-50

8" @ 318

drlg. 2133

RECORD

Cased _____ in., _____ ft.

Sand _____

Gas _____

Oil _____

Total Depth _____

PRODUCTION

1st 24 hrs. Nat. _____

1st 24 hrs. after shot _____

Gas _____ Cu. Ft.

Dry Hole _____

Abandoned _____

Date

JUN 28 1950 19

J. E. TYRA Scout

FORM 275 FOR SALE BY KANSAS BLUE PRINT CO.


County Barton State ~~Kansas~~

Sec. 12 (Blk. Twp.) 17 (Sur. Rge.) 11W Map No.

Operator Elreco

Well No. 6 Farm Ehler "B"

Elev. 1890 Location SE SE SW

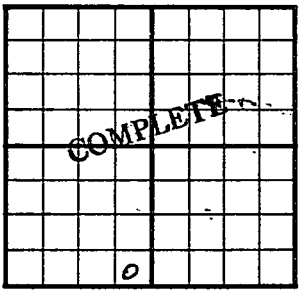

330 Ft. From S Line SW

330 Ft. From E Line Quarter

1st. Report

Completion AUG 23 1950

Remarks

Kraft-Prusa Pool

Spudding Date 6-22-50

Drlg. Data Oil well TD 3578

8" @ 318 Lans. 3034 DST 3105-12

open ½ hr. Rec. 850' gas 55' oil

Cong. 3316 Arb. 3365 Granite 3536-78 TD

5" @ 3400 CO to 3378 12/ 3106-09 500 A

5-10 goph 2000 A Comp. 40 bopd 29% wate

J. E. TYRA