


KANSAS

Section 12 Township 17 Range 11-W

Well No. #7 Ehler "B"

Company Elreco

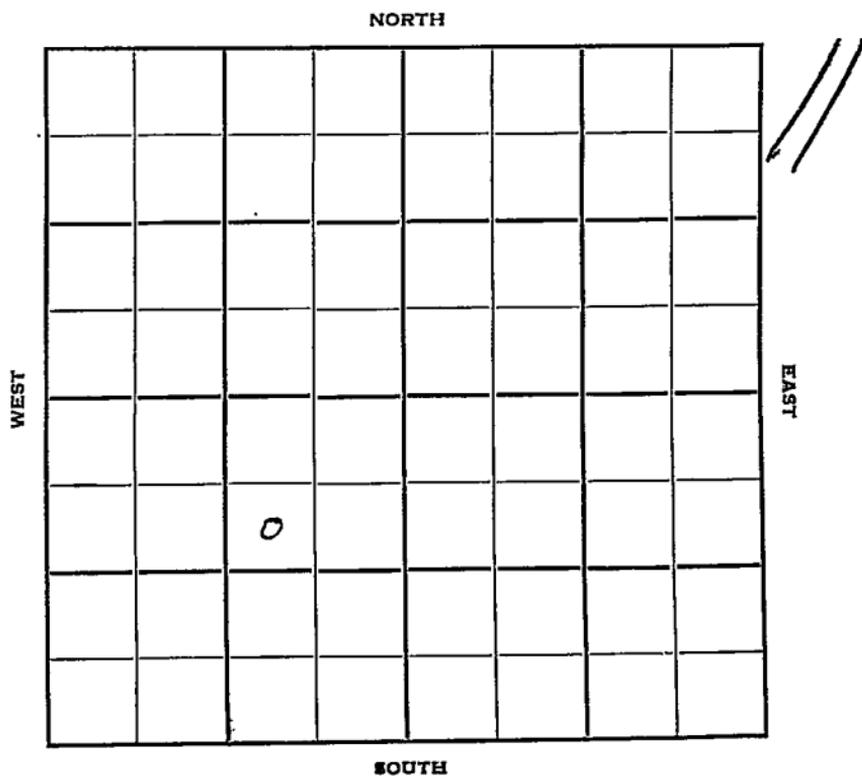

Sec. 12 Twp. 17 R. 11W ✓

Well No. #7 Ehler "B" Farm

Elreco Company

Contractor


990' Ft. from N. Line

Ft. from S. Line

990' Ft. from E. Line

Ft. from W. Line

SW NE SW

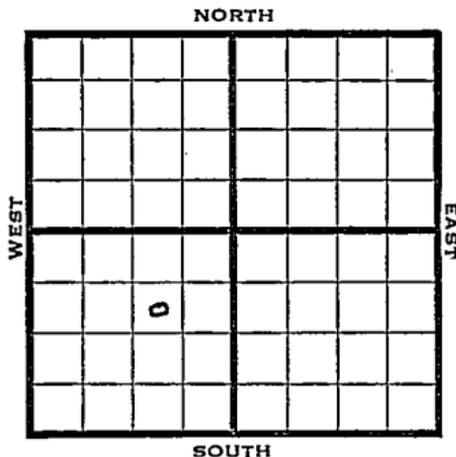

1950

Elev 1921

REPORT

7/5

Rig up

7/19

8" @ 324

Anhy 695

Heeb 2961

Br line 3059

Lans 3081

Cong 3362

TD 3423

D&A

**ABANDONED**

Kansas

Map No. \_\_\_\_\_ Sec. 12 Twp. 17 R. 11W

Well No. 7 Ehler "B"

Elreco Company

Contractor

SW NE SW

## SECTION PLAT

990 Ft. from N. Line

\_\_\_\_\_ Ft. from S. Line

990 Ft. from E. Line

\_\_\_\_\_ Ft. from W. Line



Barton County

Location \_\_\_\_\_

Rig up X

Drilling and Remarks: \_\_\_\_\_

## RECORD

Cased \_\_\_\_\_ in., \_\_\_\_\_ ft.

Sand \_\_\_\_\_

Gas \_\_\_\_\_

Oil \_\_\_\_\_

Total Depth \_\_\_\_\_

## PRODUCTION

1st 24 hrs. Nat. \_\_\_\_\_

1st 24 hrs. after shot \_\_\_\_\_

Gas \_\_\_\_\_ Cu. Ft.

Dry Hole \_\_\_\_\_

Abandoned \_\_\_\_\_

Date

JUL 5 1950 19

J. E. TYRA Scout

**RECORDED**

Map No. \_\_\_\_\_ Sec. 12 Twp. 17 R. 11W

Well No. 7 Ehler "B"

Elreco Company

Contractor

SW NE SW


**El. 1921  
SECTION PLAT**

990 Ft. from N. Line

\_\_\_\_\_ Ft. from S. Line

990 Ft. from E. Line

\_\_\_\_\_ Ft. from W. Line

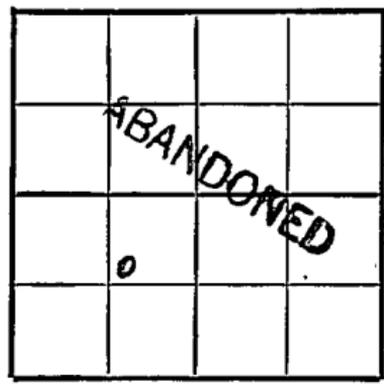

Barton County

Location \_\_\_\_\_

Rig up \_\_\_\_\_

Drilling and Remarks:

8" @ 324  
 Anhy 695  
 Heeb. 2961  
 Br. limē 3059  
 Lans. 3081  
 Cong. 3362  
 TD 3423

**RECORD**

Cased \_\_\_\_\_ in., \_\_\_\_\_ ft.  
 Sand \_\_\_\_\_  
 Gas \_\_\_\_\_  
 Oil \_\_\_\_\_  
 Total-Depth 3423

**PRODUCTION**

1st 24 hrs. Nat. \_\_\_\_\_  
 1st 24 hrs. after shot \_\_\_\_\_  
 Gas \_\_\_\_\_ Cu. Ft.  
 Dry Hole \_\_\_\_\_  
 Abandoned \_\_\_\_\_

D & A

Date

**JUL 19 1950**

19

**J. E. TYRA** Scout