

KANSAS

FORM 51 5M 4-41 PETROL

Barton

Section 12 Township 17 Range 11-W

Well No. 5 Fee

Company Transwestern et al


Kraft Pool

NORTH

WEST

EAST

SOUTH

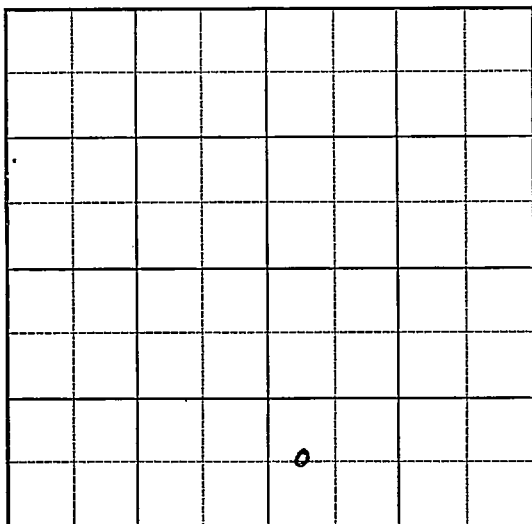

KANSAS**Barton**Sec. 12 Twp. 17 R. 11-WWell No. #5 Fee Farm _____Transwestern et al Company**(Kraft)**


_____ Ft. from N. Line

660 Ft. from S. Line

_____ Ft. from E. Line

330 Ft. from W. Line

Elev. 1891

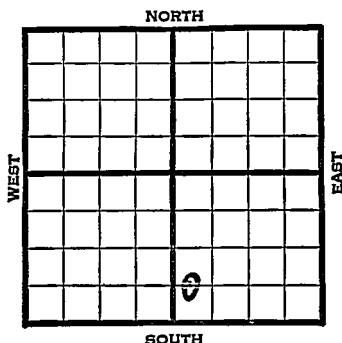

1941

REPORT

5/7

Rotary.

5/15

8" - 277' Drilg. 1960'

5/22

Lans. 3008' Arb. 3302-03' T.D.

5" - 3303' RUST.

5/28

" " "

6/5

T.D. 3314' 3000' oil 5 hours.

6/12

" " " "

6/18

Arb. 3302'

5" - 3303'

T.D. 3314'

Depthograph Potential 3708 bbls.

Maximum 3000 bbls.

43.6 Gravity

COMPLETED

Map No. 55 Sec. 12 Twp. 17 R. 11WWell No. 5 Fee

Transwestern etal

Company

FIRST REPORT

Contractor

C W L SW SE

 Ft. from N. Line660 Ft. from S. Line Ft. from E. Line330 Ft. from W. Line

SECTION PLAT

KRAFT POOL

Location Rig up

Drilling and Remarks:

Rotary

RECORD

Cased in., ft.Sand Gas Oil Total Depth

PRODUCTION

1st 24 hrs. Nat. 1st 24 hrs. after shot Gas Cu. Ft.Dry Hole Abandoned

Date

MAY 7 1941

S. J. LEWIS

Scout

Map No. 55 Sec. 12 Twp. 17 R. 11WWell No. 5 FeeTranswestern etal Company

Contractor

COMPLETED

SECTION PLAT

C W L SW SE

 Ft. from N. Line660 Ft. from S. Line Ft. from E. Line330 Ft. from W. Line

KRAFT POOL

Location Rig up

Drilling and Remarks:

*Cor 3302**5" 3303**Dep to 3305**Max 3000**436 gr*

RECORD

Cased in., ft.Sand Gas Oil Total Depth 3314

PRODUCTION

1st 24 hrs. Nat. 1st 24 hrs. after shot Gas Cu. Ft.Dry Hole Abandoned

Date

JUN 18 1941

19

S. J. LEWIS

Scout