


KANSAS

Section 12 Township 17 Range 11W

Well No. #6 Krautwurst

Company Sunray

Kraft - Prusa ^{NORTH}

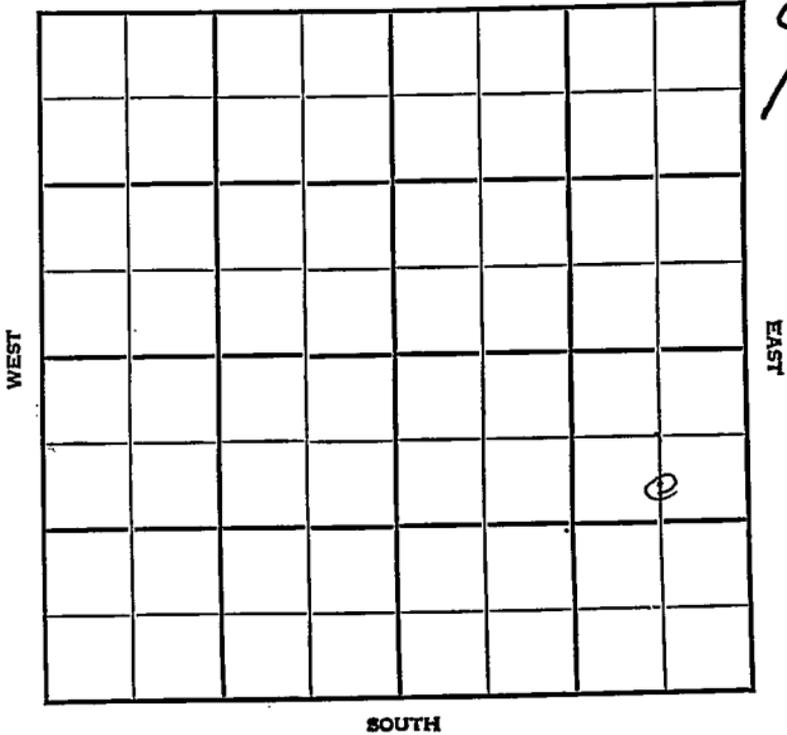

Sec. 12 Twp. 17 R. 11W

Well No. #6 Krautwurst Farm

Sunray Company

Kraft-Prusa


990 Ft. from N. Line

_____ Ft. from S. Line

660 Ft. from E. Line

_____ Ft. from W. Line

G S L N E S E

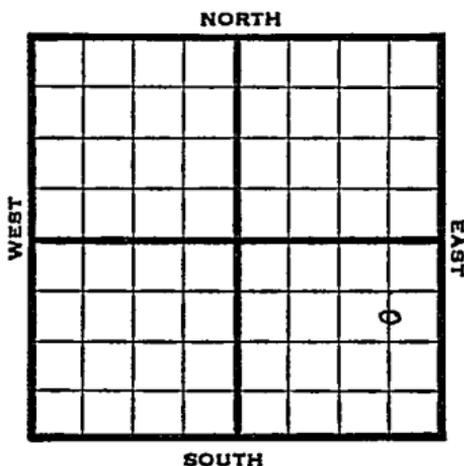

1948

EL 1904'

REPORT

4/7 Location

4/14 "

4/21 "

4/28 "

5/5 13" @ 276'
Drlg. 1823'

5/12 Lansing 3017'
Drlg. 3278'

5/19 BKC 3262'
Arbuckle 3340'
TD 3342'
7" @ 3341'
RUST

5/26 TD 3347' 500 acid
Bail 1 bailer oil PH

6/1 "

6/9 "

6/16 "

6/23 TD 3347'
Arb. 3340'
7"@ 3341' 500 acid
Pump 76 oil Pot
22° Gr.
Comp.

COMPLETED

Map No. _____ Sec. 12 Twp. 17 R. 11W

Well No. 6 Krautwurst

Sunray Company

FIRST REPORT

Contractor

C S L NE SE

SECTION PLAT

990 Ft. from N. Line

_____ Ft. from S. Line

660 Ft. from E. Line

_____ Ft. from W. Line

Barton County

RECORD

Location X

Rig up _____

Drilling and Remarks:

Cased _____ in., _____ ft.

Sand _____

Gas _____

Oil _____

Total Depth _____

PRODUCTION

1st 24 hrs. Nat. _____

1st 24 hrs. after shot _____

Gas _____ Cu. Ft.

Dry Hole _____

Abandoned _____

Date

APR 7 1948

19

S. J. LEWIS

Scout

Map No. 55 Sec. 12 Twp. 17 R. 11W

Well No. 6 Krautwurst

Sunray Company

COMPLETE

Contractor

C S L NE SE

E 11904
SECTION PLAT

990 Ft. from N. Line

 Ft. from S. Line

660 Ft. from E. Line

 Ft. from W. Line

			o

Barton County

Location

Rig up

Drilling and Remarks:

Cl 3340
7" @ 3341
500 cu. ft.
Prod 76 oil Pt
42° Cu

RECORD

Cased in., ft.

Sand

Gas

Oil

Total Depth 3347

PRODUCTION

1st 24 hrs. Nat.

1st 24 hrs. after shot

Gas Cu. Ft.

Dry Hole

Abandoned

Date

JUN 23 1948 19 S. J. LEWIS Scout