


Section 12 Township 17 Range 11 W

Well No. #7 Andrea

Company Sunray

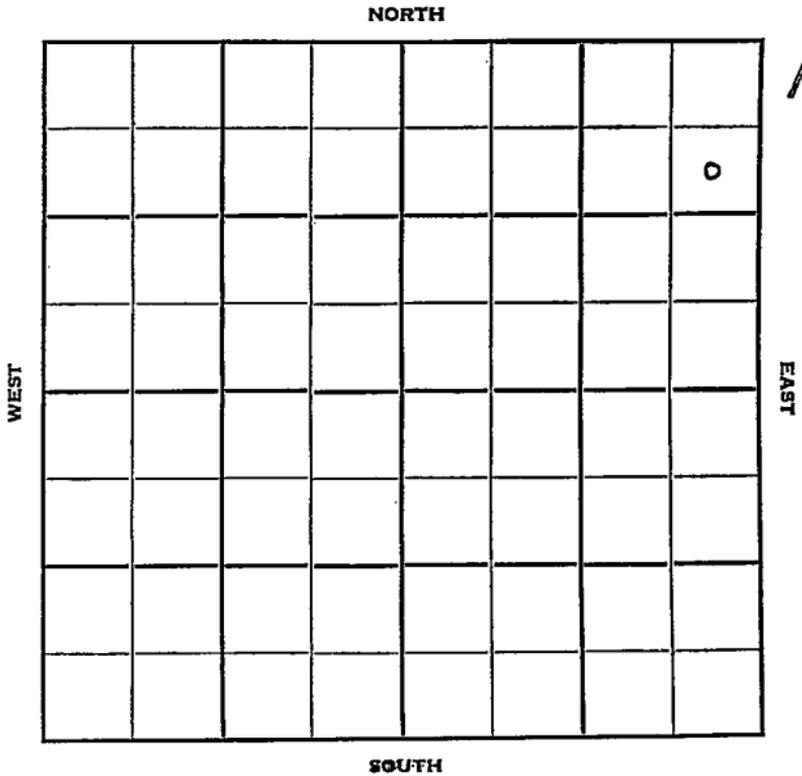

Sec. 12 Twp. 17 R. 11W

Well No. #7 Andrea Farm
Sunray Company

Mouser Drlg.-Contr. Contractor
Kraft-Prusa Pool


990' Ft. from N. Line

_____ Ft. from S. Line

330' Ft. from E. Line

_____ Ft. from W. Line

SE NE NE

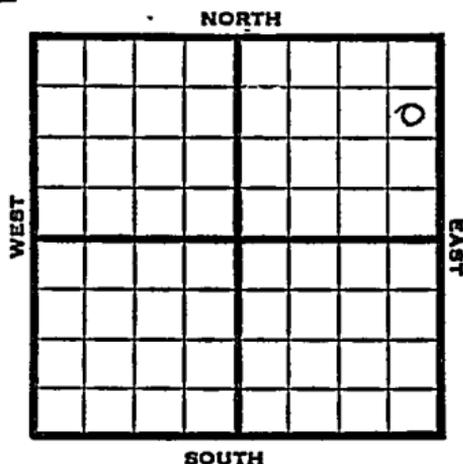

1951 Elev. 1941' REPORT

1/31 Spud 1-28-51
10" @ 371
WOC

3/14 Spud =1-28-51
Oil Well TD 3411'
10" @ 371'
Heeb. 2953' Lans. 3071'
DST 3157-65 opn 1 hr Rec. 45' hgcm
180' oil
Arb. 3407'
TD 3411' 5" @ 3409'
24/3263-69 1000 A 15 gwph SP 3236
16/3159-63 1 goph 3000 A S/10 boph
Comp. 318 Bopd 15% wtr.

COMPLETED

County Barton State Kansas

Sec. 12 (Blk. 17) (Twp. 11W) (Sur. Rge.) 11W Map No.

Operator Sunray

Well No. 7 Farm Andrea

Elev. _____ Location SE NE NE

| | | | | | | | | | |
|--|--|--|--|--|--|--|--|--|--|
| | | | | | | | | | |
| | | | | | | | | | |
990 Ft. From N Line NE
 330 Ft. From E Line Quarter

1st. Report JAN 31 1951

Completion _____

Remarks _____

Mouser Drig. - Contr.

Spudding Date 1-28-51

Drig. Data Kraft-Prusa Pool

10" @ 371 WOC

