


Section 12 Township 17 Range 11W

Well No. 7 Krautwurst

Company Sunray

**Kraft-Prusa**  
NORTH

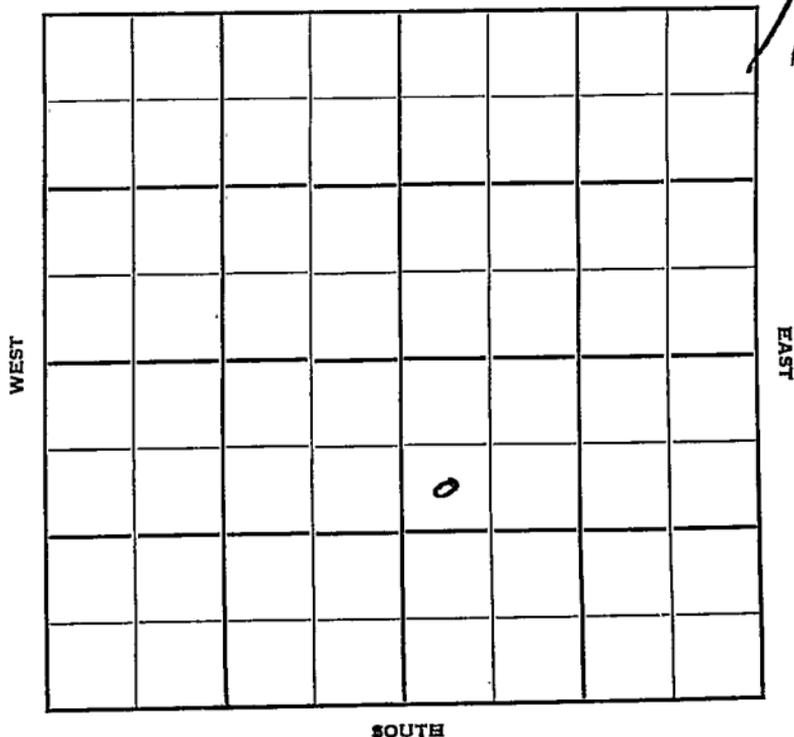

Kansas

Barton ✓

Sec. 12 Twp. 17 R. 11-11

Well No. #7 Krautwurst Farm

Sunray Company


(Mouser Drlg. Contractor)<sup>NORTH</sup>

990 Kraft-Prusa  
Ft. from N. Line

\_\_\_\_\_ Ft. from S. Line

\_\_\_\_\_ Ft. from E. Line

330 Ft. from W. Line

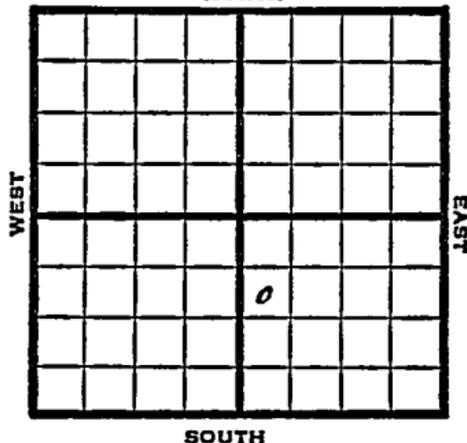

**SWNW SE**

1949

Elev 1899'

REPORT

8/10

Location

8/17

8" @ 296'

Drlg 2066'

8/24

Lansing 3035'

Arbuckle 3345-58

TD 5" @ 3346.

8/31

2000 acid

Swb 5 bbls oil PH

9/7

"

9/14

TD 3348'

Arb. 3345'

5" @ 3346'

2000 acid

Pump 220 Oil Pot

42° Gr.

Comp

**COMPLETED**

Map No. \_\_\_\_\_ Sec. 12 Twp. 17 R. 11W

Well No. 7 Krautwurst

Sunray Company

Mouser Drlg. Contractor

SW NW SE

FIRST REPORT  
SECTION PLAT

990 Ft. from N. Line

\_\_\_\_\_ Ft. from S. Line

\_\_\_\_\_ Ft. from E. Line

330 Ft. from W. Line

		0	

Barton County

RECORD

Location X

Cased \_\_\_\_\_ in., \_\_\_\_\_ ft.

Rig up \_\_\_\_\_

Sand \_\_\_\_\_

Drilling and Remarks:

Gas \_\_\_\_\_

Oil \_\_\_\_\_

Total Depth \_\_\_\_\_

PRODUCTION

1st 24 hrs. Nat. \_\_\_\_\_

1st 24 hrs. after shot \_\_\_\_\_

Gas \_\_\_\_\_ Cu. Ft.

Dry Hole \_\_\_\_\_

Abandoned \_\_\_\_\_

Date

AUG 10 1949

19

S. I. FWIS

Scout

Map No. K-55 Sec. 12 Twp. 17 R. 11W

Well No. 7 Krautwurst

Sunnay Company

**COMPLETE**

Contractor

SW NW SE

*E. 1899*


SECTION PLAT

990 Ft. from N. Line

         Ft. from S. Line

         Ft. from E. Line

330 Ft. from W. Line

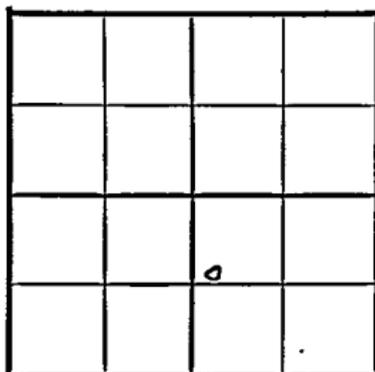

Barton County

Location                                 

Rig up                                 

Drilling and Remarks:

*CR 3345*  
*5" CR 346*  
*20000000*  
*Prod 220 oil Prod*  
*420 ft*

**RECORD**

Cased          in.,          ft.

Sand                                 

Gas                                 

Oil                                 

Total Depth 3345

**PRODUCTION**

1st 24 hrs. Nat.                                 

1st 24 hrs. after shot                                 

Gas                                  Cu. Ft.

Dry Hole                                 

Abandoned                                 

Date

SEP 14 1949

19

S. J. LEWIS Scout