

# KANSAS

Barton

Section 12 Township 17S Range 11W

Well No. #8 Krautwurst

Company Sunray Oil Corp.

NORTH

*10*

WEST

					0		

EAST

SOUTH

Sec. 12 Twp. 17 R. 11-W

Well No. #8 Krautwurst Farm \_\_\_\_\_

Sunray

Company \_\_\_\_\_

Kraft-Prusa


330 Ft. from N. Line

\_\_\_\_\_ Ft. from S. Line

\_\_\_\_\_ Ft. from E. Line

990 Ft. from W. Line

NORTH

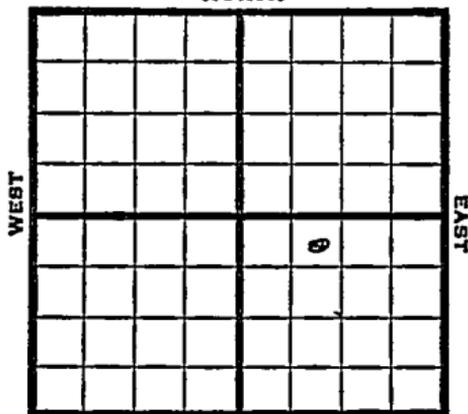

SOUTH

NE NW-SE

1949

Elev. 1909' REPORT

10/12

Location

10/19

8" @ -273'

10/26

Lansing 3045'

Drlg. 3085'

11/1

Arbuckle 3342

TD 3351'

5" @3444'

Swb 50 bbls oil 1 hr.

11/9

TD 3357'

800 acid swb 15 bbls oil PH

11/23

TD 3357'

Arb. 3342'

5 @ 3344'

900 acid

Pump 235 Oil Pot

42° Gr.

Comp

**COMPLETED**

Map No. \_\_\_\_\_ Sec. 12 Twp. 17 R. 11W

Well No. 8 Krautwurst

Sunray Company

Contractor \_\_\_\_\_

NE NW SE

FIRST REPORT  
SECTION PLAT

330 Ft. from N. Line

\_\_\_\_\_ Ft. from S. Line

\_\_\_\_\_ Ft. from E. Line

990 Ft. from W. Line

		o	

Barton County

Location X

Rig up \_\_\_\_\_

Drilling and Remarks:

RECORD

Cased \_\_\_\_\_ in., \_\_\_\_\_ ft.

Sand \_\_\_\_\_

Gas \_\_\_\_\_

Oil \_\_\_\_\_

Total Depth \_\_\_\_\_

PRODUCTION

1st 24 hrs. Nat. \_\_\_\_\_

1st 24 hrs. after shot \_\_\_\_\_

Gas \_\_\_\_\_ Cu. Ft.

Dry Hole \_\_\_\_\_

Abandoned \_\_\_\_\_

Date

OCT 12 1949 19

S. J. LEWIS

Scout

Kansas

Map No. \_\_\_\_\_ Sec. 12 Twp. 17 R. 11W

Well No. 8 Krautwurst

\_\_\_\_\_ Sunray \_\_\_\_\_ Company

**COMPLETE**

Contractor

NE NW SE

*E 11909*  
SECTION PLAT

330 Ft. from N. Line

\_\_\_\_\_ Ft. from S. Line

\_\_\_\_\_ Ft. from E. Line

990 Ft. from W. Line

		o	

Barton County

Location \_\_\_\_\_

Rig up \_\_\_\_\_

Drilling and Remarks:

*Core 3342*

*5" core 3344*

*900 acid*

*Prod 235 oil*

*42 2/3*

**RECORD**

Cased \_\_\_\_\_ in., \_\_\_\_\_ ft.

Sand \_\_\_\_\_

Gas \_\_\_\_\_

Oil \_\_\_\_\_

Total Depth 2257

**PRODUCTION**

1st 24 hrs. Nat. \_\_\_\_\_

1st 24 hrs. after shot \_\_\_\_\_

Gas \_\_\_\_\_ Cu. Ft.

Dry Hole \_\_\_\_\_

Abandoned \_\_\_\_\_

Date

NOV 23 1949

19

S. I. LEWIS Scout