


Section 12 Township 17 Range 11W

Well No. #9 Andrea

Company Sunray

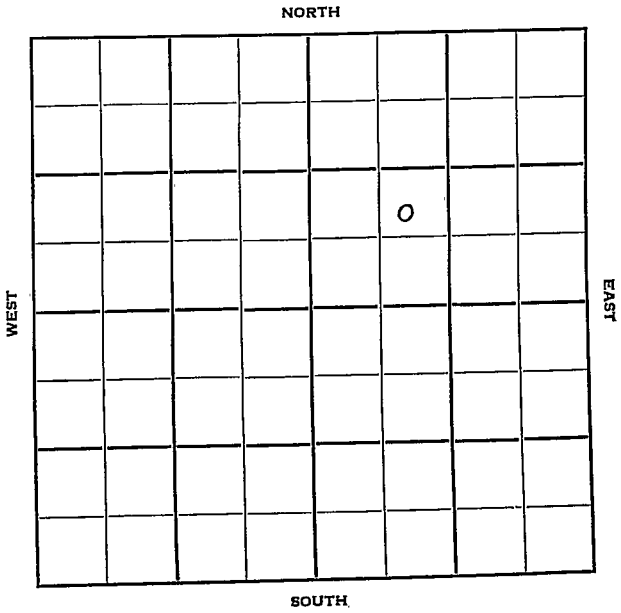

Barton

Sec. 12 Twp. 17 R. 11W

Well No. #9 Andrea Farm

Sunray Company

Mouser - Contr. Contractor

Draft Prusa Pool


\_\_\_\_\_ Ft. from N. Line

990' Ft. from S. Line

\_\_\_\_\_ Ft. from E. Line

990' Ft. from W. Line

NE SW NE

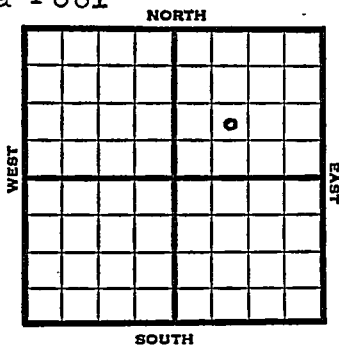

1951 Elev. 1949' REPORT

9/19 Spud 9-16-51  
8" @ 278'

10/31 Spud 9-16-51  
Oil well TD 3409' 8" @ 278  
Kans. 3080'  
DST 3163-71 open 45 min. rec 30' mud  
& SSO  
Arb. 3400'  
DST 3401-04 open 1/2 hr. rec 5' mud  
TD 3409' 5" @ 3403' CO to 3409.  
FU 800' oil S/5 BOPH  
Comp. 357 BOPD

COMPLETED



