

(7)

State Kansas County Sheridan


Company G.M.-R Oil Well No. 1

Farm Scheetz

Survey \_\_\_\_\_

Block No. \_\_\_\_\_ Sec. 35 Twp. 7 Range 26W

Co-Ord. \_\_\_\_\_ Elev. <sup>2500</sup> 2516 K.B.

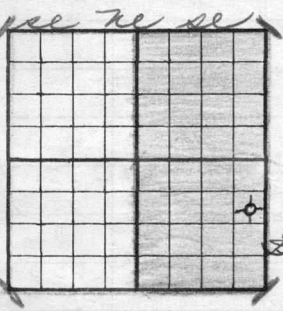

Rig #3 2495 Gr.

10% - Wm. Graham Oil Co.

40% - G.M.-R Oil Co.

50% - Chicago

~~Ac. to call J. J. Harris~~  
print

NOTE: Show Sketch of Lease and Well Location in Above Space

Ft. from N. Line 1650 Ft. from S. Line \_\_\_\_\_

Ft. from W. Line 330 Ft. from E. Line \_\_\_\_\_

Date	Depth	
<u>1953</u>		<u>Spudded - 5-27-53</u>
		<u>8 5/8" @ 200 w/150 sp.</u>
		<u>4 C.C.</u>
<u>5-29</u>		<u>545 - at 3:30 a.m.</u>
		<u>after motor fixed</u>
<u>6-1</u>	<u>3160</u>	<u>Drly</u>
<u>6-2</u>	<u>3438</u>	<u>-</u>
<u>6-3</u>	<u>3730</u>	<u>-</u>
<u>6-</u>		


714852

Date	Depth	
6/3/53	3656	Heeb (-1156)
	3677	Ice (-1177)
	3698	Lans. (-1198)
#1.	D.S.T. #1	3720-42' Open
	1 hr. <sup>W.P.S.</sup> Rec. 90'	NY OTCM. Muddy oil
		50% oil BHP. 1090 #15
6-5-53	D.S.T. #2	-3766-90 - rec. 100'
		hvy. OCM. - 120' sw
		B.H.P. - 1130 #15 ( <del>1292</del> )
	3908	K.C. (base) (-1408)
		(no bottom)
6-4	3951	Dry.
6-6	4080	R.T.D.
		5 1/2" @ 3909' w/ 100' of
6-20		M.J.C. T. flower prof. below
6-21	- hvy 3722-26' and 3737-41' / 125	3 1/2" @ 1000' a. - after
		8-9 hrs. - 500 gal. left
		swld. back & lost.
		4 hrs. made aboph
		and 1 buph
6-22		3 1/2" @ acidize with
		1000 more acid plus
		what was left (500 gal)
		swld. 3 1/2 haph
		and 1/2 buph
6-24		Swld. 1/2 haph & 1 buph Dec 6-24-53

State Kansas County Sheldahl  
 Company G. M. R. Oil Well No. 1  
 Farm Scheetz  
 Survey \_\_\_\_\_

Block No. \_\_\_\_\_ Sec. 35 Twp. 7 Range 26 W

Co-Ord. \_\_\_\_\_ Elev. 2516 K.B.

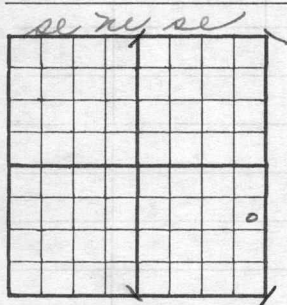

Rig # 3

NOTE: Show Sketch of Lease and Well Location in Above Space

Ft. from N. Line 1650 Ft. from S. Line \_\_\_\_\_

Ft. from W. Line 330 Ft. from E. Line \_\_\_\_\_

Date	Depth	
<u>1953</u>		
<u>6-20</u>	<u>3782-92</u>	<u>- perf. w/3" per ft. subd. 2 bwp/4 hrs. Plug back to 3778</u>
<u>6-21</u>	<u>3764-72</u>	<u>- perf. w/3" per ft. subd. 2 bwp/5 goph for 6 hrs. Plug back to 3750</u>
		<u>&amp; tested 3722-41 (above)</u>
		<u>D &amp; A 6-24-53</u>