


KANSAS

Section 12 Township 17 Range 11-W

Well No. #11 Hogan "A"

Company Cities Service

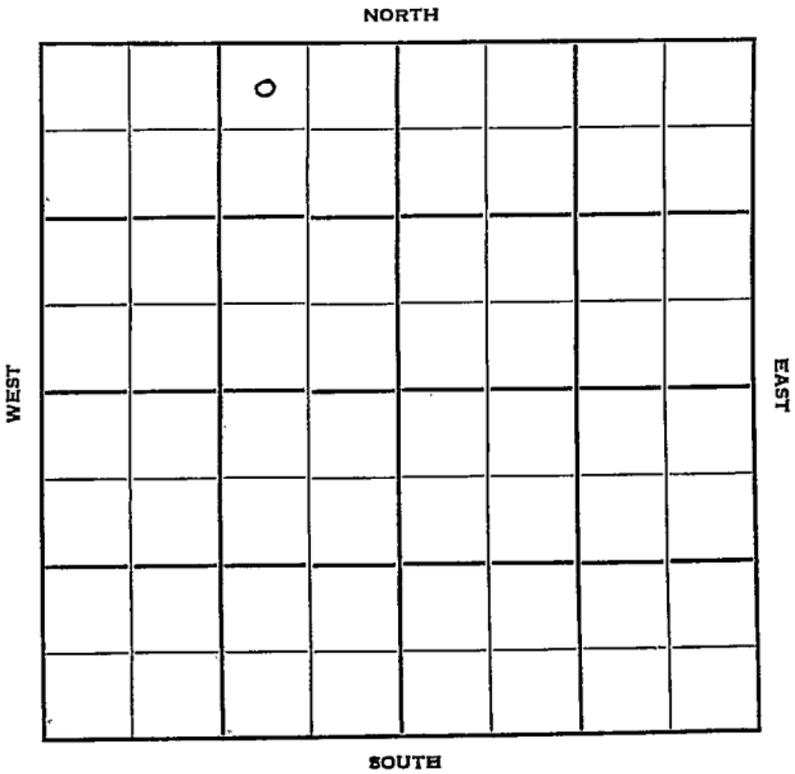

Sec. 12 Twp. 17 R. 11W

Well No. #11 Hogan "A" Farm

Cities Service Company

Kraft Prusa Pool Contractor


330' Ft. from N. Line

\_\_\_\_\_ Ft. from S. Line

990' Ft. from E. Line

\_\_\_\_\_ Ft. from W. Line

NW NE NW

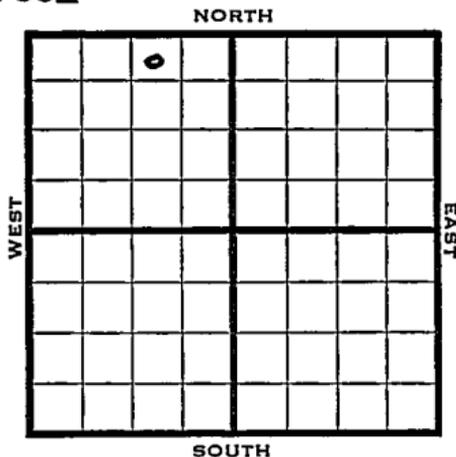

1950 Elev 1965 REPORT

8/16 Location

9/20 Spud 8-22-50

8" @ 365

Top 2763

Lans 3115

Arb 3409

5" @ 3414

T 3419 1000 A

2 1/2 boph 8 hr DD 3422 FU 1100' oil

13 hr 1500 A

Comp 49 bopd

Completed

**COMPLETED**



County Barton State KansasSec. 12 (Blk. 17) (Sur. 11W) (Twp. 17) (Rge. 11W) Map No.Operator Cities ServiceWell No. 11 Farm Hogan "A"Elev. 1965 Location NW NE NW

		o			

330 Ft. From N Line NW990 Ft. From E Line Quarter1st. Report ~~SEP 20 1950~~Completion SEP 20 1950

Remarks

Kraft-Prusa PoolSpudding Date 8-22-50Drig. Data Oil well TD 34228" @ 365 Top. 2763 Lans. 3115Arb. 3409 5" @ 3414 TD 3419 1000 A2 $\frac{1}{2}$  boph 8 hr. DD 3422 FU 1100' oil13 hr. 1500 A Comp. 49 bopd

J. E. TYRA