


Trego

Section 26 Township 12 Range 21 W

Well No. # 2 Schoenthaler

Company Texas Company

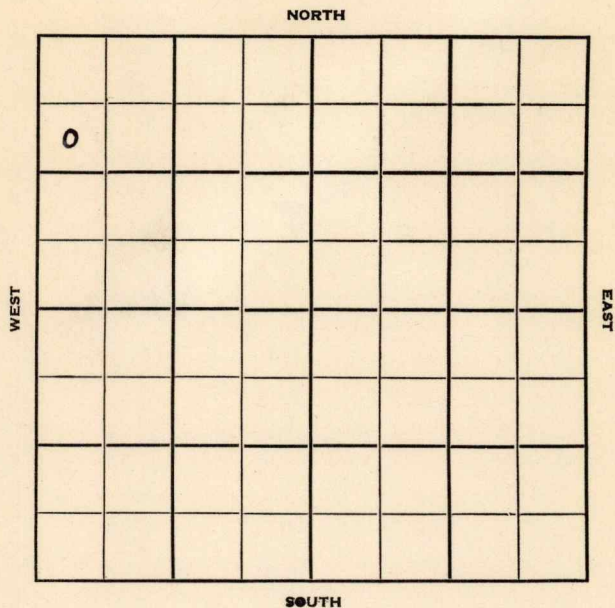

Trego

KANSAS

Sec. 26 Twp. 12 R. 21W

Well No. #2 Schoenthaler Farm

Texas Co. Company

Noble Contractor

Ellis NW


990 Ft. from N. Line

_____ Ft. from S. Line

_____ Ft. from E. Line

330 Ft. from W. Line

SWNW NW

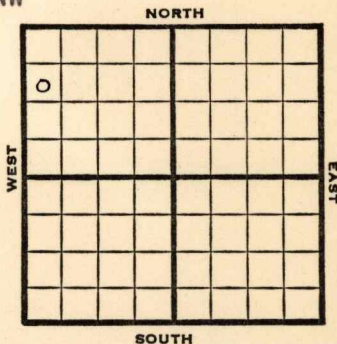

1952 **Elev. 2220'** REPORT

2/13 Spud 2-9-52
10" @ 510'
Drlg. 1000'

2/20 **Heeb 3470' Lans. 3506'**
Drlg. 3755'

3/5 Spud 2-9-52
SWD Well TD 4160
10" @ 510 **Heeb. 3470**
Lans. 3506
DST 3545-70 opn 1 hr. Rec. 55' muddy
wtr
Cong. 3855
DST 3700-08 opn 1 hr. Rec. 3' mud
Arb. 3940 TD 4160
7" @ 3994 Comp. for SWD well

ABANDONED

County **Trego** State **Kansas**

Sec. **26** (Blk.) **12** (Sur.) **21W** Map No.

Operator **Texas Co.**

Well No. **2** Farm **Schoenthaler**

Elev. **2220** Location **SW NW NW**

FIRST REPORT

990 Ft. From **N** Line **NW**

³³⁰
~~990~~ Ft. From **W** Line **Quarter**

Ist. Report **FEB 13 1952**

Completion

Remarks

Noble - Contr.

Spudding Date **2-9-52**

Drlg. Data **Ellis NW**

10" @ 510 Drlg. 1000

J. G. MCGEHEE

County Trego State Kansas

Sec. 26 (Blk. 12) (Sur. Rge.) 21W Map No.

Operator Texas Company

Well No. 2 Farm Schoenthaler

Elev. 2220 Location SW NW NW

0					

ABANDONED

990 Ft. From N Line NW

330 Ft. From W Line Quarter

1st. Report

Completion MAR 5 1952

Remarks NW Ellis Pool

Noble Drlg. - Contr.

Spudding Date 2-9-52

Drlg. Data SWD well TD 4160

10" @ 510 Heeb. 3470 Lans. 3506

DST 3545-70 open 1 hr. Rec. 55' muddy sw

Cong. 3855 DST 3700-08 open 1 hr.

Rec. 3' mud Arb. 3940 TD 4160

7" @ 3994 Comp. for SWD well