

Woodson

Map No. KANSAS Sec. 1 Twp. 24 R. 13E


Well No. 1 - Dewey Farm
Shull Oil Co. Company

 Ft. from N. Line

450 Ft. from S. Line

335 Ft. from E. Line

 Ft. from W. Line

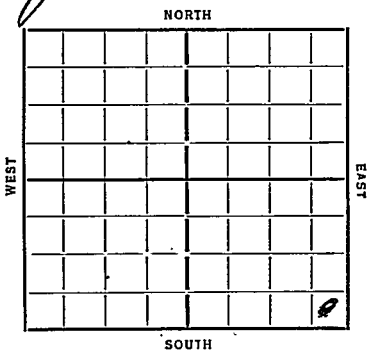

Date	REPORT
1935	
6/19	Dly 150
6/28	760 set 10"
7/3	Dly 865 10" 790
7/11	Time 1652
	Pay 1690-98 acidize
7/18	Time 1645
	Pay 1683-91 200 oil
8/7	Top Time 1652
	Oil 1683-91
	T.D. 1691
	10 oil
	30 water
	COMPLETED

Map No. 17 Sec. 1 Twp. 24 R. 13E

Well No. 1 - Dewey

Shull Dege Company

Contractor

FIRST REPORTS

..... Ft. from N. Line

450 Ft. from S. Line

335 Ft. from E. Line

..... Ft. from W. Line

SECTION PLAT

Location.....

Rig up.....

Drilling and Remarks:

104 150

RECORD

Cased..... in., ft.

Sand.....

Gas.....

Oil.....

Total Depth.....

PRODUCTION

1st 24 hrs. Nat.....

1st 24 hrs. after shot.....

Gas..... Cu. Ft.

Dry Hole.....

Abandoned.....

Date

6-19-35 192.....

Scout

WANTCHRECK

Map No. 17 Sec. 1 Twp. 24 R. 13E

Well No. 1-Dewey

Shull Oil Co Company

Contractor

COMPLETION

SECTION PLAT

..... Ft. from N. Line

450 Ft. from S. Line

335 Ft. from E. Line

..... Ft. from W. Line

			0

Location.....

Rig up.....

Drilling and Remarks:

1000 acid

10 oil
30 water

RECORD

Cased..... in., ft.

Sand TL 1652

Gas.....

Oil 1683-91

Total Depth 1691

PRODUCTION

1st 24 hrs. Nat.....

1st 24 hrs. after shot.....

Gas..... Cu. Ft.

Dry Hole.....

Abandoned.....

Date

8-7-35 192

ORVAL MANNSCHECK

Scout