

**STATE CORPORATION COMMISSION OF KANSAS
OIL & GAS CONSERVATION DIVISION**

**WELL COMPLETION OR RECOMPLETION FORM
ACO-1 WELL HISTORY**

DESCRIPTION OF WELL AND LEASE

Operator: license # 5198
name A. Scott Ritchie
address 125 N. Market, Suite 950
City/State/Zip Wichita, KS 67202

Operator Contact Person Rocky Milford
Phone (316) 267-4375

Contractor: license # 6033
name Murfin Drilling Co.

Wellsite Geologist Ed Louis
Phone (316) 264-2773

PURCHASER Koch Oil Co.

Designate Type of Completion

☒ New Well ☐ Re-Entry ☐ Workover

☒ Oil ☐ SWD ☐ Temp Abd
☐ Gas ☐ Inj ☐ Delayed Comp.
☐ Dry ☐ Other (Core, Water Supply etc.)

WELL HISTORY

Operator Rocky Milford
Well Name 135, 22, 568
Comp. Date 8/31/84 Old Total Depth 4382'

WELL HISTORY

Drilling Method: ☒ Mud Rotary ☐ Air Rotary ☐ Cable

7/25/84 8/4/84 8/31/84
Spud Date Date Reached TD Completion Date

4382' RTD n/a
Total Depth PBD

Amount of Surface Pipe Set and Cemented at 264 feet

Multiple Stage Cementing Collar Used? ☒ Yes ☐ No

If Yes, Show Depth Set 1660 feet

If alternate 2 completion, cement circulated
from 264 feet depth to surface w/ 175 SX cmt

API NO. 15 - 135, 22, 568

County Ness

320' FSL & 1680'

FEL, SE/4 Sec 27 Twp 16S Rge 22 X

(location)

320' Ft North from Southeast Corner of Sect
1680' Ft West from Southeast Corner of Sect
(Note: locate well in section plat below)


Lease Name Pfaff "A" Well# 1

Field Name Brownell SW

Producing Formation Mississippi

Elevation: Ground 2373' KB 2382'

Section Plat

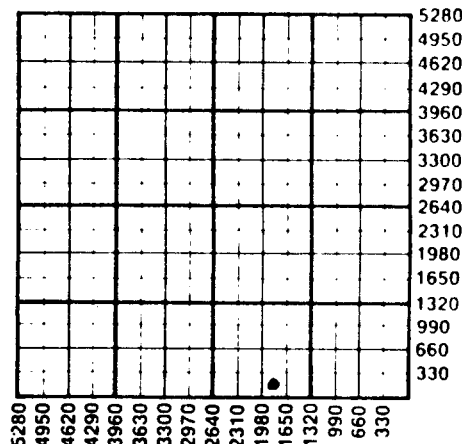

WATER SUPPLY INFORMATION

Source of Water:

Division of Water Resources Permit #

☐ Groundwater. Ft North From Southeast Corner
(Well) Ft West From Southeast Corner
Sec Twp Rge East West

☐ Surface Water. Ft North From Southeast Corner
(Stream, Pond etc.) Ft West From Southeast Corner
Sec Twp Rge East West

☐ Other (explain) _____
(purchased from city, R.W.D. #)

Disposition of Produced Water: ☐ Disposal
☐ Repressuring

Docket #

INSTRUCTIONS: This form shall be completed in duplicate and filed with the Kansas Corporation Commission, 200 Colorado Derby Building, Wichita, Kansas 67202, within 90 days after completion or recompletion of any well. Rules 82-3-130 and 82-3-107 apply.

Information on side two of this form will be held confidential for a period of 12 months if requested in writing and submitted with the form. See rule 82-3-10 for confidentiality in excess of 12 months.

One copy of all wireline logs and drillers time log shall be attached with this form. Submit CP-4 form with all plugged wells. Submit CP-111 form with all temporarily abandoned wells.